

Registration Statement

OF CLAIMANT OF RIGHT TO APPROPRIATE GROUND WATER

TO THE STATE ENGINEER OF OREGON:

I, ELBERT C. DRAKE
 of ROUTE #1, Box #213, EUGENE County of LANE
(Mailing address)
 State of OREGON, do hereby make application for a certificate of registration as evidence
 of a right to appropriate ground water.

1. Source from which water is withdrawn is PUMP WELL
(Flowing well, pump well, infiltration trench, or tunnel)

2. Location is: 6 1/2 MILES NW of EUGENE
(Approximate distance and direction from nearest city or town)

and is more particularly described as follows: 1070 feet south & 440 feet east from NW corner Section 8

(a) 1/4 MILE SOUTH & LITTLE EAST
(Give distance and bearing to corner of section or other legal subdivision)

being within NW 1/4 of the NORTHWEST QUARTER of Sec. 17, Twp. 17 S., Rge. 4 W.
(Smallest legal subdivision) (N. or S.) (E. or W.)

or (b) within limits of recorded platted property, town or city:

in Lot _____, Block _____ of _____
(Name of plat or addition)

County of LANE
(If within city or town, give name)

3. Construction Work was begun on 4/52; was completed on 5/52
(Date) (Date)

and the ground water claimed was first used for the purposes set out below on 2/52
(Date)

since which time the water has been used INTERMITTENTLY
(Continuously or Intermittently)

from 6/52 to PRESENT 7/20/52
(Date) (Date)

4. Quantity of water claimed and used is 150 gallons per minute; _____ acre
 feet per year.

5. Purpose or Purposes for which water is used IRRIGATION

(Domestic, irrigation, municipal, manufacturing, industrial, etc.)

6. Description of Well: Depth 31 feet. Type DRILLED
(Dug or drilled)

diameter 5 inches. Elevation of ground at well site 3116 feet, mean sea level.
(As near as known)

Depth to water table 14 feet.

7. Capacity of Well: 150 g.p.m. with 2 to 3 feet drawdown.
ADDITIONAL CAPACITY NOT KNOWN
 _____ g.p.m. with _____ feet drawdown.

Date of test 2/52

If Flowing Well: Measured discharge _____ g.p.m. on _____
(Date)

Shut-in pressure at ground surface _____ lbs. per sq. in. on _____
(Date)

Water is controlled by _____
(Cap, valve, etc.)

8. Casing: (Give diameter, commercial specifications and depth below ground surface of each casing size.)

5 inch diameter *PIPE* from 0 to 33 feet
 inch diameter from to feet
 inch diameter from to feet
 inch diameter from to feet

Describe and show depth of shoe, plug, adapter, liner or other details: *Open 5" pipe*

9. Perforated Casings or Screens:

None

(Number per foot and size of perforations, or describe screen)

from to
 from to
 from to
 from to

10. Log of Well: (Describe each stratum or formation clearly, indicate if water bearing, and give thickness and depth as indicated.)

MATERIAL	Thickness (Feet)	Depth to Bottom (Feet)
TOP SOIL	2'	33'
PLY GRAVEL - SOME WATER AT 15'	12'	18'
SAND - SOME WATER	3'	15'
COURSE GRAVEL AND SAND - WATER	1.5'	0'
MORE AT THIS DEPTH		

If log of well is not available, give name and address of driller. DRIVER SELF

HOME MADE DRILL RIG

11. Infiltration Trench: Covered or open

Dimensions: Length ft. Minimum depth ft. Maximum depth ft.

Bottom width ft. Discharge g.p.m. Date of test

12. Tunnel: Type of lining

Dimensions:
(Length, course, and cross sectional size)

Position of water bearing stratum with reference to portal of tunnel

Log of tunnel: (Preceding table for log of well may be used, if desired. Give footage from portal and character of materials, as pertinent.)

13. Pumping Equipment:

(a) Pump MYERS ELECTRIC & FLUMAN GAS Capacity 110 GALS g.p.m.
(Make, type and size) TO REC.

(b) Motor SINGER PARSE 2HP WISCONSIN 6HP
(Type and Horsepower)

14. Location of area irrigated or to be irrigated, or place of use if for purposes other than irrigation.

Township North or South	Range E. or W. of Willamette Meridian	Section	Forty-acre Tract	Number Acres To Be Irrigated	Date of Reclamation
17 S	4 W	NW 1/4 #8	NW 1/4 of NW 1/4 NW 1/4 #8	25.0	1952

15. If the ground water supply is supplemental to an existing water supply, identification of any application for a permit, permit, certificate or adjudicated right to appropriate water made or held by the registrant.


WELL IS ONLY SOURCE OF WATER. NO OTHER APPLICATION OR PERMIT HELD.

Township 175, Range 4W, W.M.

North

AREA IRRIGATED
25 ACRES

LOCATION
OF WELL

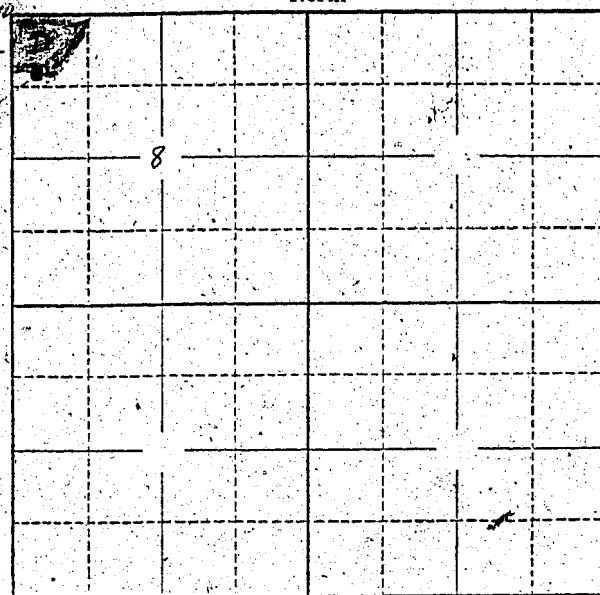

Locate well and acreage of irrigated land on plat.

Scale: 2" = 1 Mile

STATE OF OREGON

County of Lane } ss.

I, Albert O. Drake, being first duly sworn, do hereby certify that I have read the foregoing Registration Statement and that all of the items therein contained are true to the best of my knowledge and belief.

Albert O. Drake

(Signature of Registrant)

Subscribed and sworn to before me this 25th day of July, 1952

My commission expires 2-23-62

[Signature]

(Notary Public)

(SEAL)

CERTIFICATE OF REGISTRATION

STATE OF OREGON

County of Marion } ss.

This is to certify that the foregoing Registration Statement was received in the office of the State Engineer on the 31st day of July, 1952, at 2:00 o'clock A.M. and has been duly recorded in said office in Book No. 13 of Registration Statements on page GR-3125

Witness my hand this 16th day of June, 1959

Lewis A. Stanley

(State Engineer)

By _____ (Deputy)

\$15.00

GR - 3125