REGISTRATION NO. GR-339

CERTIFICATE NO. GR-324

# Registration Statement

## OF CLAIMANT OF RIGHT TO APPROPRIATE GROUND WATER

(Under Chapter 708, Oregon Laws 1955.)

**TO THE STATE ENGINEER OF OREGON:**

I, Guy W. Smith & Gilda J. Smith 5955 McLeod

of Salem County of Marion

State of Oregon, do hereby make application for a certificate of registration as evidence of a right to appropriate ground water.

1. **Source** from which water is withdrawn is Pump well (Flowing well, pump well, infiltration trench, or tunnel)

2. **Location is:** 6 miles N. Salem (Approximate distance and direction from nearest city or town);

and is more particularly described as follows:

(a) South 500' & 400' East from NW Corner Section 36 (Give distance and bearing to corner of section or other legal subdivision)

being within NW 1/4 NW 1/4 (Smallest legal subdivision) of Sec. 36, Twp. 6 S (N. or S.), Rge. 2 W (E. or W.)

or (b) within limits of recorded platted property, town or city:

in Lot ....., Block ..... of ..... (Name of plat or addition)

..... (If within city or town, give name) County of .....

3. **Construction Work** was begun on 1951 (Date); was completed on 1951 (Date)

and the ground water claimed was first used for the purposes set out below on 1951 - May (Date),

since which time the water has been used Each Irrigation Season (Continuously or intermittently)

from 1951 (Date) to 1956 (Date)

4. **Quantity** of water claimed and used is 300 gallons per minute; ..... acre feet per year.

5. **Purpose or Purposes** for which water is used Irrigation

(Domestic, irrigation, municipal, manufacturing, industrial, etc.)

6. **Description of Well:** Depth 59 feet. Type drilled (Dug or drilled)

diameter 9" at top 3' at bottom inches. Elevation of ~~ground~~ at well site ~~266~~ 148 (As near as known) feet, mean sea level.

Depth to water table 15 feet.

7. **Capacity of Well:** ..... g.p.m. with ..... feet drawdown.

..... g.p.m. with ..... feet drawdown.

Date of test .....

**If Flowing Well:** Measured discharge ..... g.p.m. on ..... (Date)

Shut-in pressure at ground surface ..... lbs. per sq. in. on ..... (Date)

Water is controlled by ..... (Cap, valve, etc.)

8. **Casing:** (Give diameter, commercial specifications and depth below ground surface of each casing size.)

3.5T inch diameter from 0 to 15 feet

9" inch diameter from 15 to 59 feet

inch diameter from to feet

inch diameter from to feet

Describe and show depth of shoe, plug, adapter, liner or other details:

9. **Perforated Casings or Screens:**

Perforated from to
(Number per foot and size of perforations, or describe screen)

from to

from to

from to

10. **Log of Well:** (Describe each stratum or formation clearly, indicate if water bearing, and give thickness and depth as indicated.)

| MATERIAL | Thickness (Feet) | Depth to Bottom (Feet) |
|---|---|---|
| not available | | |

GR-324 A

If log of well is not available, give name and address of driller. Inman Sales

11. **Infiltration Trench:** Covered or open .....

Dimensions: Length ..... ft. Minimum depth ..... ft. Maximum depth ..... ft.

Bottom width ..... ft. Discharge ..... g.p.m. Date of test .....

12. **Tunnel:** Type of lining .....

Dimensions: ..... (Length, course, and cross sectional size)

Position of water bearing stratum with reference to portal of tunnel .....

Log of tunnel: (Preceding table for log of well may be used, if desired. Give footage from portal and character of materials, as pertinent.)

13. **Pumping Equipment:**

(a) Pump Cent. (Make, type and size) Capacity 300 g.p.m.

(b) Motor 5 HP (Type and horsepower)

14. Location of area irrigated or to be irrigated, or place of use if for purposes other than irrigation.

| Township North or South | Range E. or W. of Willamette Meridian | Section | Forty-acre Tract | Number Acres To Be Irrigated | Date of Reclamation |
|---|---|---|---|---|---|
| 6 S | 3 W | 36 | NW1/4 NW1/4 | 20.7 | 1951 |
| | | | | | |
| | | | | | |
15. If the ground water supply is supplemental to an existing water supply, identification of any application for a permit, permit, certificate or adjudicated right to appropriate water made or held by the registrant.

.....

.....

GR-324B

Township 6S Range 3W, W.M.

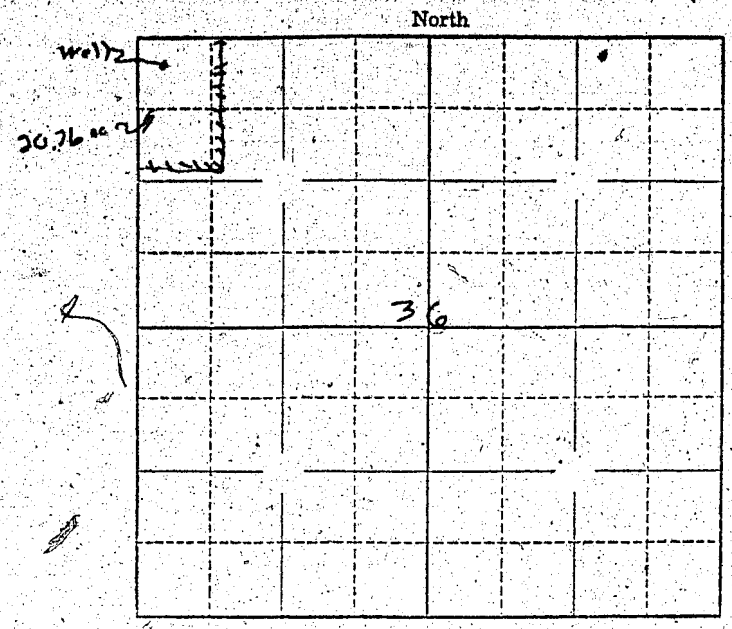


Locate well and acreage of irrigated land on plat.

Scale: ~~2"~~ 40 = 1 Mile

STATE OF OREGON
County of Marion } ss.

I, Guy H. & Golda J. Smith, being first duly sworn, do hereby certify that I have read the foregoing Registration Statement and that all of the items therein contained are true to the best of my knowledge and belief.

Guy H Smith
(Signature of Registrant)

Golda J. Smith

Subscribed and sworn to before me this 17th day of January, 1957.

My commission expires Sept 8, 1960 Chas. T. Schulz
(Notary Public)

(SEAL)

## CERTIFICATE OF REGISTRATION

STATE OF OREGON
County of Marion } ss.

This is to certify that the foregoing Registration Statement was received in the office of the State Engineer on the 17th day of January, 1957, at 4:00 o'clock P. M. and has been duly recorded in said office in Book No. 2 of Registration Statements on page GR-324 C

~~Construction shall be completed by x-x-x-x-x-x-x-x-x-x-19-x-x and the water completely applied to beneficial use by x-x-x-x-x-x-x-x-x-x-19-x-x-x~~

Witness my hand this 1st day of April, 1957

Lewis A. Stanley
(State Engineer)

By
(Deputy)

15¢

GR-324C