

# Registration Statement

## OF CLAIMANT OF RIGHT TO APPROPRIATE GROUND WATER

TO THE STATE ENGINEER OF OREGON:

I, J. M. ROYCHILD

of 410 S.W. BERGIE RD., OSWEGO County of CLATSOP

State of OREGON do hereby make application for a certificate of registration as evidence of a right to appropriate ground water.

1. Source from which water is withdrawn is PUMP WELL  
(Flowing well, pump well, infiltration trench; or tunnel)

2. Location is: 1 MILE SOUTH OF OSWEGO  
(Approximate distance and direction from nearest city or town)

and is more particularly described as follows:

(a) S 43°30' W, 330.5 FEET FROM NE CORNER OF SECTION 15  
(Give distance and bearing to corner of section or other legal subdivision)

being within SW 1/4 NE 1/4 of Sec. 15, Twp. 25, Rge. 1E  
(Smallest legal subdivision) (N. or S.) (E. or W.)

or (b) within limits of recorded platted property, town or city:

in Lot \_\_\_\_\_, Block \_\_\_\_\_ of \_\_\_\_\_  
(Name of plat or addition)

County of \_\_\_\_\_  
(If within city or town, give name)

3. Construction Work was begun on 1939; was completed on 1939  
(Date) (Date)

and the ground water claimed was first used for the purposes set out below on 1939  
(Date)

since which time the water has been used continuously  
(Continuously or intermittently)

from 1939 to Present  
(Date) (Date)

4. Quantity of water claimed and used is 25 gallons per minute; \_\_\_\_\_ acre feet per year.

5. Purpose or Purposes for which water is used exempt  
(Domestic, irrigation, municipal, manufacturing, industrial, etc.)

6. Description of Well: Depth 436 feet. Type DRILLED  
(Dug or drilled)

diameter 8 inches. Elevation of ground at well site 660 feet, mean sea level.  
(As near as known)

Depth to water table unknown feet.

7. Capacity of Well: 25 g.p.m. with \_\_\_\_\_ feet drawdown.

\_\_\_\_\_ g.p.m. with \_\_\_\_\_ feet drawdown.

Date of test 1939

If Flowing Well: Measured discharge \_\_\_\_\_ g.p.m. on \_\_\_\_\_  
(Date)


Shut-in pressure at ground surface \_\_\_\_\_ lbs. per sq. in. on \_\_\_\_\_  
(Date)

Water is controlled by \_\_\_\_\_  
(Cap, valve, etc.)





Township 25 Range 1E, W.M.  
North

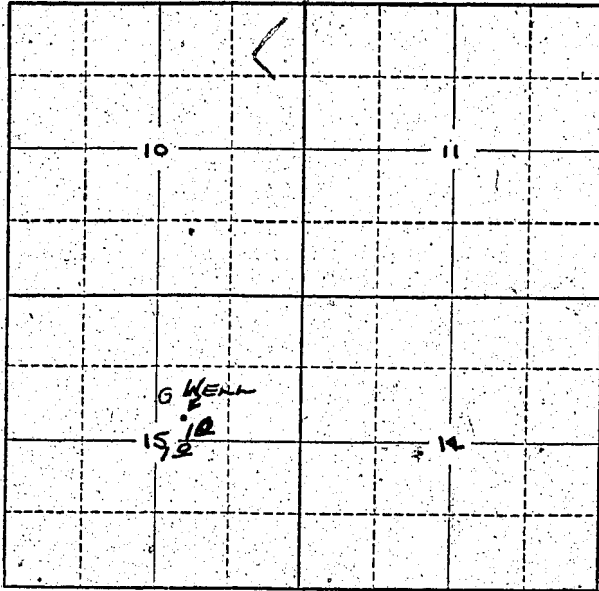

Locate well and acreage of irrigated land on plat.  
Scale: 2" = 1 Mile

STATE OF OREGON

County of Multnomah ss.

I, Mr. Raphael, being first duly sworn, do hereby certify that I have read the foregoing Registration Statement and that all of the items therein contained are true to the best of my knowledge and belief.

[Signature]  
(Signature of Registrant)

Subscribed and sworn to before me this 30 day of July, 1958

My commission expires Feb. 18, 1960

[Signature]  
(Notary Public)

(SEAL)

**CERTIFICATE OF REGISTRATION**

STATE OF OREGON

County of Marion } ss.

This is to certify that the foregoing Registration Statement was received in the office of the State Engineer on the 31<sup>st</sup> day of July, 1958, at 2:00 o'clock A.M. and has been duly recorded in said office in Book No. 13 of Registration Statements on page GR-3131

Witness my hand this 16<sup>th</sup> day of June, 1959

[Signature]  
(State Engineer)

By \_\_\_\_\_ (Deputy)

GR - 3131

\$15.00