

Registration Statement

OF CLAIMANT OF RIGHT TO APPROPRIATE GROUND WATER

TO THE STATE ENGINEER OF OREGON:

I, Ambrose Brownell

of Box 5965, Milwaukie, Oregon County of Clackamas

State of Oregon, do hereby make application for a certificate of registration as evidence of a right to appropriate ground water.

1. Source from which water is withdrawn is Pump Well
(Flowing well, pump well, infiltration trench, or tunnel)

2. Location is: Three miles South of Milwaukie, Oregon
(Approximate distance and direction from nearest city or town)

and is more particularly described as follows:

The well is situated S 27° 32' E 101.52' and S 66° 30' W 30'

(a) From the N.E. Cor. of the Stephen Walker D.L.C.
(Give distance and bearing to corner of section or other legal subdivision)

being within N.E. 1/4 and S.E. 1/4 of Sec. 12, Twp. 2 S., Rge. 1 E.
(Smallest legal subdivision) (N. or S.) (E. or W.)

or (b) within limits of recorded platted property, town or city:

in Lot _____, Block _____ of _____

(Name of plat or addition)

(If within city or town, give name)

County of Clackamas

3. Construction Work was begun on September 1931; was completed on April 1932
(Date) (Date)

and the ground water claimed was first used for the purposes set out below on April 1932
(Date)

since which time the water has been used continuously
(Continuously or intermittently)

from April 1932 to July 1958
(Date) (Date)

4. Quantity of water claimed and used is 75 gallons per minute; _____ acre feet per year.

5. Purpose or Purposes for which water is used Irrigation and Fruit

(Domestic, irrigation, municipal, manufacturing, industrial, etc.)

6. Description of Well: Depth 235 feet. Type drilled
(Dug or drilled)

diameter 8" inches. Elevation of ground at well site 125 feet, mean sea level.
(As near as known)

Depth to water table 25 feet.

7. Capacity of Well: 75 g.p.m. with 120 feet drawdown.

_____ g.p.m. with _____ feet drawdown.

Date of test April 1932

If Flowing Well: Measured discharge No g.p.m. on _____
(Date)

Shut-in pressure at ground surface _____ lbs. per sq. in. on _____
(Date)

Water is controlled by _____
(Cap, valve, etc.)

8. Casing: (Give diameter, commercial specifications and depth below ground surface of each casing size.)

8 inch diameter from 0 to 90 feet
..... inch diameter from to feet
..... inch diameter from to feet
..... inch diameter from to feet

Describe and show depth of shoe, plug, adapter, liner or other details:

9. Perforated Casings or Screens: None

(Number per foot and size of perforations, or describe screen)

..... from to
..... from to
..... from to
..... from to

10. Log of Well: (Describe each stratum or formation clearly, indicate if water bearing, and give thickness and depth as indicated.)

MATERIAL	Thickness (Feet)	Depth to Bottom (Feet)

If log of well is not available, give name and address of driller.

Carah Bros., 9945 S.W. Highway 217, Beaverton, Oregon

11. Infiltration Trench: Covered or open None

Dimensions: Length ft. Minimum depth ft. Maximum depth ft.

Bottom width ft. Discharge g.p.m. Date of test

12. Tunnel: Type of lining None

Dimensions:
(Length, course, and cross sectional size)

Position of water bearing stratum with reference to portal of tunnel

Log of tunnel; (Preceding table for log of well may be used, if desired. Give footage from portal and character of materials, as pertinent.)

13. Pumping Equipment:

(a) Pump Pomona Capacity 75 g.p.m.
(Make, type and size)


(b) Motor 5 HP
(Type and horsepower)

14. Location of area irrigated or to be irrigated, or place of use if for purposes other than irrigation.

Township North or South	Range E. or W. of Willamette Meridian	Section	Forty-acre Tract	Number Acres To Be Irrigated	Date of Reclamation
2 S	1 E	12	SW 1/4; NE 1/4	5.50	1932
2 S	1 E	12	NW 1/4; SE 1/4	7.26	"
				<u>12.76</u>	"

15. If the ground water supply is supplemental to an existing water supply, identification of any application for a permit, permit, certificate or adjudicated right to appropriate water made or held by the registrant.
.....
.....

Township 25 Range 1E W.M.
North

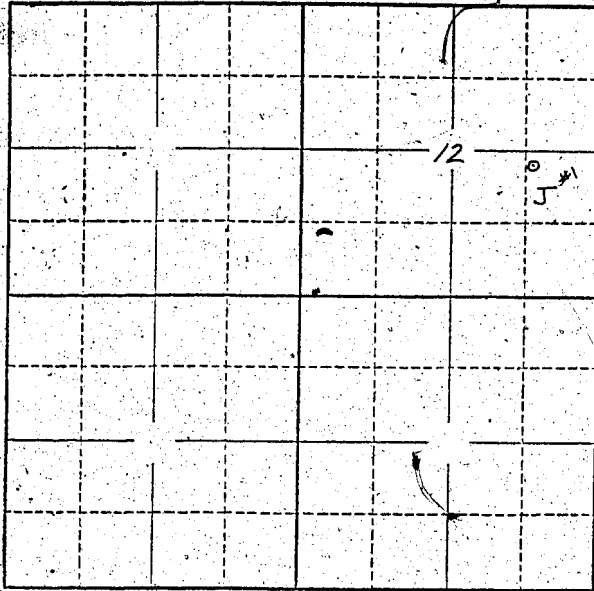

See Map Attached

Locate well and acreage of irrigated land on plat.
Scale: 2" = 1 Mile

STATE OF OREGON

County of Clackamas } ss.

I, Ambrose Brownell, being first duly sworn, do hereby certify that I have read the foregoing Registration Statement and that all of the items therein contained are true to the best of my knowledge and belief.

Ambrose Brownell
(Signature of Registrant)

Subscribed and sworn to before me this _____ day of _____, 19____

My commission expires _____ (Notary Public)

(SEAL)

CERTIFICATE OF REGISTRATION

STATE OF OREGON

County of Marion } ss.

This is to certify that the foregoing Registration Statement was received in the office of the State Engineer on the 31st day of July, 1952, at 2:00 o'clock A.M. and has been duly recorded in said office in Book No. 13 of Registration Statements on page GR-3132

Witness my hand this 16th day of June, 1959

Lewis A. Stanley
(State Engineer)

By _____ (Deputy)

\$15.00