

# Registration Statement

## OF CLAIMANT OF RIGHT TO APPROPRIATE GROUND WATER



TO THE STATE ENGINEER OF OREGON:

I, Ambrose Brownell

of Box 5965, Milwaukie, Oregon County of Clackamas

State of Oregon, do hereby make application for a certificate of registration as evidence of a right to appropriate ground water.

1. Source from which water is withdrawn is Pump Well #2  
(Flowing well, pump well, infiltration trench, or tunnel)

2. Location is: Three miles South of Milwaukie, Oregon  
(Approximate distance and direction from nearest city or town)

and is more particularly described as follows:

(a) S 27° 32' E 752.52' and S. 60° 28' W 50' from the N.E. Cor. Stephen Walker  
(Give distance and bearing to corner of section or other legal subdivision)

being within NE 1/4 S.E. 1 of Sec. 12, Twp. 2 S, Rge. 1 E  
(Smallest legal subdivision) (N. or S.) (E. or W.)

or (b) within limits of recorded platted property, town or city:

in Lot \_\_\_\_\_, Block \_\_\_\_\_ of \_\_\_\_\_  
(Name of plat or addition)

County of Clackamas

(If within city or town, give name)

3. Construction Work was begun on October 1946; was completed on June, 1947  
(Date) (Date)

and the ground water claimed was first used for the purposes set out below on June, 1947  
(Date)

since which time the water has been used continuously  
(Continuously or intermittently)

from June 1947 to July 1958  
(Date) (Date)

4. Quantity of water claimed and used is 130 gallons per minute; \_\_\_\_\_ acre feet per year.

5. Purpose or Purposes for which water is used Irrigation and Poultry Farming

(Domestic, irrigation, municipal, manufacturing, industrial, etc.)

6. Description of Well: Depth 300 feet. Type Drilled  
(Dug or drilled)

diameter 8" inches. Elevation of ground at well site 125 feet, mean sea level.  
(As near as known)

Depth to water table 26 feet.

7. Capacity of Well: 45 g.p.m. with 53 feet drawdown.

132 g.p.m. with 158 feet drawdown.

Date of test November 19, 1946

If Flowing Well: Measured discharge Pump Well g.p.m. on \_\_\_\_\_  
(Date)


Shut-in pressure at ground surface \_\_\_\_\_ lbs. per sq. in. on \_\_\_\_\_  
(Date)

Water is controlled by \_\_\_\_\_  
(Cap, valve, etc.)





Township 25 Range 1E W.M.  
North

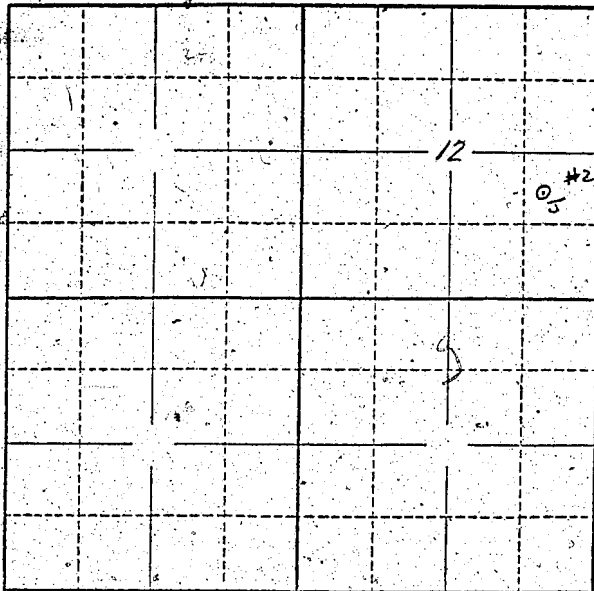

See Map Attached

Locate well and acreage of irrigated land on plat.  
Scale: 2" = 1 Mile

STATE OF OREGON

County of Clackamas } ss.

I, Ambrose Bromell, being first duly sworn, do hereby certify that I have read the foregoing Registration Statement and that all of the items therein contained are true to the best of my knowledge and belief.

Ambrose Bromell  
(Signature of Registrant)

Subscribed and sworn to before me this \_\_\_\_\_ day of \_\_\_\_\_, 19\_\_\_\_

My commission expires \_\_\_\_\_  
(Notary Public)

(SEAL)

**CERTIFICATE OF REGISTRATION**

STATE OF OREGON

County of Marion } ss.

This is to certify that the foregoing Registration Statement was received in the office of the State Engineer on the 31st day of July, 1958 at 2:00 o'clock A.M. and has been duly recorded in said office in Book No. 13 of Registration Statements on page GR 3133

Witness my hand this 16th day of June, 1959

Lewis A. Stanley  
(State Engineer)

By \_\_\_\_\_  
(Deputy)

#15.00