

RECEIVED

GR-3398

# Registration Statement

CERTIFICATE NO. GR-3115

## OF CLAIMANT OF RIGHT TO APPROPRIATE GROUND WATER

(Under Chapter 708, Oregon Laws 1955.)

TO THE STATE ENGINEER OF OREGON:

I, Chris G. Lindseth

of PT # 3, Box 620 County of Benton

State of Oregon do hereby make application for a certificate of registration as evidence of a right to appropriate ground water.

1. Source from which water is withdrawn is Pump Well  
(Flowing well, pump well, infiltration trench, or tunnel)

2. Location is: 6 miles North of Monroe  
(Approximate distance and direction from nearest city or town)

and is more particularly described as follows:

(a) N 56° E. 621.87 FT  
(Give distance and bearing to corner of section or other legal subdivision)

being within S.W. corner of NW 1/4 SW 1/4 of Sec. 36, Twp. 13 S., Rge. 5 W.  
(Smallest legal subdivision) (N. or S.) (E. or W.)

or (b) within limits of recorded platted property, town or city:

in Lot \_\_\_\_\_, Block \_\_\_\_\_ of \_\_\_\_\_  
(Name of plat or addition)

County of \_\_\_\_\_

(If within city or town, give name)

3. Construction Work was begun on \_\_\_\_\_; was completed on 1947  
(Date) (Date)

and the ground water claimed was first used for the purposes set out below on 1947  
(Date)

since which time the water has been used: Intermittently in Season  
(Continuously or intermittently)

from June to Sep.  
(Date) (Date)

4. Quantity of water claimed and used is 300 gallons per minute; 60 acre feet per year.

5. Purpose or Purposes for which water is used Agriculture

(Domestic, irrigation, municipal, manufacturing, industrial, etc.)

6. Description of Well: Depth 219 feet. Type Drilled  
(Dug or drilled)

diameter 4 inches. Elevation of ground at well site 250 feet, mean sea level.  
(As near as known)

Depth to water table 13 feet.

7. Capacity of Well: \_\_\_\_\_ g.p.m. with \_\_\_\_\_ feet drawdown.

Not known g.p.m. with \_\_\_\_\_ feet drawdown.

Date of test \_\_\_\_\_

If Flowing Well: Measured discharge \_\_\_\_\_ g.p.m. on \_\_\_\_\_  
(Date)


Shut-in pressure at ground surface \_\_\_\_\_ lbs. per sq. in. on \_\_\_\_\_  
(Date)

Water is controlled by \_\_\_\_\_  
(Cap, valve, etc.)





Township 13 S. Range 5 W. W.M.  
North

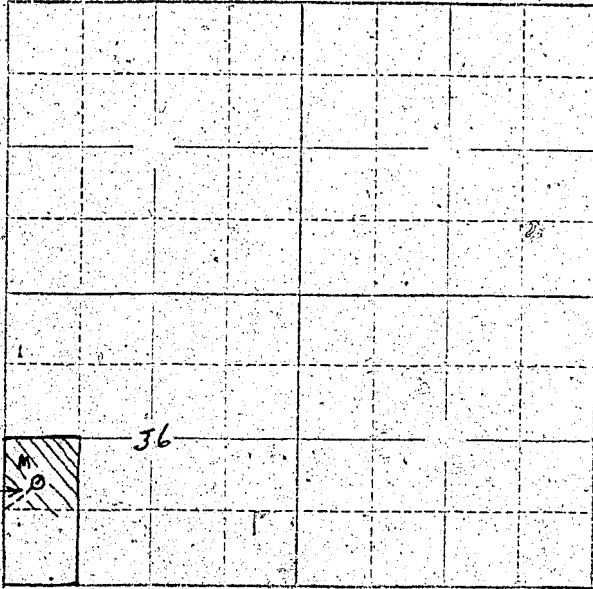

N. 56° E.  
621.87 FT

Locate well and acreage of irrigated land on plat.  
Scale: 2" = 1 Mile

STATE OF OREGON

County of Benton

ss.

I, Chris C. Lindseth, being first duly sworn, do hereby certify that I have read the foregoing Registration Statement and that all of the items therein contained are true to the best of my knowledge and belief.

Chris C. Lindseth  
(Signature of Registrant)

Subscribed and sworn to before me this 29<sup>th</sup> day of July, 1958

My commission expires May 22, 1961

Laura S. Turner  
(Notary Public)

(SEAL)

CERTIFICATE OF REGISTRATION

STATE OF OREGON

County of Marion

ss.

This is to certify that the foregoing Registration Statement was received in the office of the State Engineer on the 31 day of July, 1958, at 8:00 o'clock A.M. and has been duly recorded in said office in Book No. 13 of Registration Statements on page GR-3145

~~Construction shall be completed by xxxxxxxxxxxxxxxx and the entire amount applied to xxxxxxxxxxxxxxxx for xxxxxxxxxxxxxxxx~~

Witness my hand this 16<sup>th</sup> day of June, 1959

Lewis A. Stanley  
(State Engineer)

By \_\_\_\_\_  
(Deputy)

GR-3145

16.50