

RECEIVED
JAN 18 1957
STATE ENGINEER
SALEM, OREGON

REGISTRATION NO. GR-340
CERTIFICATE NO. GR-325

Registration Statement

OF CLAIMANT OF RIGHT TO APPROPRIATE GROUND WATER

(Under Chapter 702, Oregon Laws 1955.)

TO THE STATE ENGINEER OF OREGON:

I, Mrs. J. Reese Mallow
of 1153 Filmore, Corvallis County of Benton

State of Oregon, do hereby make application for a certificate of registration as evidence of a right to appropriate ground water.

- 1. Source from which water is withdrawn is pump well
(Flowing well, pump well, infiltration trench, or tunnel)
- 2. Location is: 2 1/2 miles south of Corvallis
(Approximate distance and direction from nearest city or town)

and is more particularly described as follows:

(a) 1380' S 67° west from the NE corner of Sec. 15
(Give distance and bearing to corner of section or other legal subdivision)

being within NE 1/4 NE 1/4 of Sec. 15, Twp. 13 S, Rge. 5W
(Smallest legal subdivision) (T. or S.) (E. or W.)

or (b) within limits of recorded platted property, town or city:

in Lot _____, Block _____ of _____
(Name of plat or addition)
County of _____
(If within city or town, give name)

3. Construction Work was begun on Mar. 30, 1950; was completed on May 1, 1950
(Date) (Date)

and the ground water claimed was first used for the purposes set out below on May 1, 1950
(Date)

since which time the water has been used continuously
(Continuously or Intermittently)

from May 1, 1950 to Jan. 1, 1957 (in season)
(Date) (Date)

4. Quantity of water claimed and used is 100 gallons per minute; appr. 40 acre feet per year.

5. Purpose or Purposes for which water is used irrigation
(Domestic, irrigation, municipal, manufacturing, industrial, etc.)

6. Description of Well: Depth 65 feet. Type drilled
(Dug or drilled)

diameter 6 inches. Elevation of ground at well site 220 feet, mean sea level.
(As near as known)

Depth to water table _____ feet.

7. Capacity of Well: unknown g.p.m. with _____ feet drawdown.
are pumping 100 g.p.m. with 10 feet drawdown.

Date of test none

If Flowing Well: Measured discharge _____ g.p.m. on _____
(Date)

Shut-in pressure at ground surface _____ lbs. per sq. in. on _____
(Date)

Water is controlled by _____
(Cap, valve, etc.)

8. Casing: (Give diameter, commercial specifications and depth below ground surface of each casing size.)

6 inch diameter 20#/ft. from surface to 41 feet
 inch diameter from to feet
 inch diameter from to feet
 inch diameter from to feet

Describe and show depth of shoe, plug, adapter, liner or other details:

9. Perforated Casings or Screens:

unknown from to
 (Number per foot and size of perforations, or describe screen)
 from to
 from to
 from to

10. Log of Well: (Describe each stratum or formation clearly, indicate if water bearing, and give thickness and depth as indicated.)

MATERIAL	Thickness (Feet)	Depth to Bottom (Feet)
Clay	21	21
Sand and gravel	20	41
Cemented gravel	14	55
Black sand	10	65

GR-325A

If log of well is not available, give name and address of driller.

11. Infiltration Trench: Covered or open

Dimensions: Length ft. Minimum depth ft. Maximum depth ft.
Bottom width ft. Discharge g.p.m. Date of test

12. Tunnel: Type of lining

Dimensions:
(Length, course, and cross sectional size)
Position of water bearing stratum with reference to portal of tunnel

Log of tunnel: (Preceding table for log of well may be used, if desired. Give footage from portal and character of materials, as pertinent.)

13. Pumping Equipment:

(a) Pump Peerless pump - deep well turbine - 3" turbine Capacity (?) 150 g.p.m.
(Make, type and size)
(b) Motor GE repulsion induction - 5 h.p.
(Type and horsepower)


14. Location of area irrigated or to be irrigated, or place of use if for purposes other than irrigation.

Township North or South	Range E. or W. of Willamette Meridian	Section	Forty-acre Tract	Number Acres To Be Irrigated	Date of Reclamation
13 S	5 W	15	NE $\frac{1}{4}$ NE $\frac{1}{4}$	5	May, 1950
13 S	5 W	15	NE $\frac{1}{4}$ NE $\frac{1}{4}$	<u>11</u> <u>16</u>	May, 1950

15. If the ground water supply is supplemental to an existing water supply, identification of any application for a permit, permit, certificate or adjudicated right to appropriate water made or held by the registrant.

Township 15 S Range 5 W W.M.

North

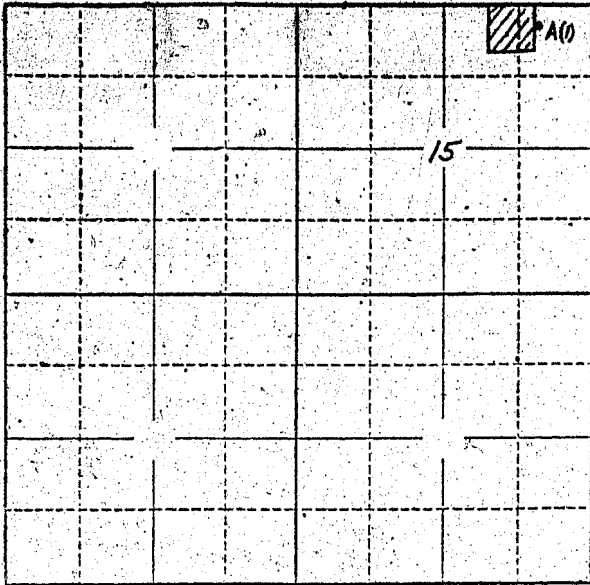

Locate well and acreage of irrigated land on plat.

Scale: 2" = 1 Mile

STATE OF OREGON

County of Benton } ss.

I, Miss J. Reese Mallow, being first-duly sworn, do hereby certify that I have read the foregoing Registration Statement and that all of the items therein contained are true to the best of my knowledge and belief.

Miss J. Reese Mallow
(Signature of Registrant)

Subscribed and sworn to before me this 17th day of January, 1957.

My commission expires April 29, 1960 Suea Wriggleworth
(Notary Public)

(SEAL)

CERTIFICATE OF REGISTRATION

STATE OF OREGON }
County of Marion } ss.

This is to certify that the foregoing Registration Statement was received in the office of the State Engineer on the 18th day of January, 1957, at 8:00 o'clock A. M. and has been duly recorded in said office in Book No. 2 of Registration Statements on page GR-325 C.

~~Construction shall be completed by X-X-X-X-X-X-X-X-X-X and the water completely applied to beneficial use by X-X-X-X-X-X-X-X-X-X~~

Witness my hand this 1st day of April, 1957
Luva A. Stanley
(State Engineer)

\$15.00

By _____
(Deputy)

GR-325C