

RECEIVED  
JUL 1 1953

Registration No. GR-340

Certificate No. GR-3145

# Registration Statement

## OF CLAIMANT OF RIGHT TO APPROPRIATE GROUND WATER

TO THE STATE ENGINEER OF OREGON:

I, Herbert C. Bower  
of 100 Prairie Road Junction City County of Lane  
(Mailing address)

State of Oregon, do hereby make application for a certificate of registration as evidence of a right to appropriate ground water.

1. Source from which water is withdrawn is Flow Well  
(Flowing well, pump well, infiltration trench, or tunnel)

2. Location is: 1/4 mile south of Junction City  
(Approximate distance and direction from nearest city or town)

and is more particularly described as follows:

(a) 350' south and 200' west from NE corner, section 6  
(Give distance and bearing to corner of section or other legal subdivision)

being within NE 1/4 NE 1/4 of Sec. 6, Twp. 16 S, Rge. 4 W  
(Smallest legal subdivision) (N. or S.) (E. or W.)

or (b) within limits of recorded platted property, town or city

in Lot \_\_\_\_\_, Block \_\_\_\_\_ of \_\_\_\_\_  
(Name of plat or addition)

County of \_\_\_\_\_  
(If within city or town, give name)

3. Construction Work was begun on August 1953; was completed on August 1953  
(Date) (Date)

and the ground water claimed was first used for the purposes set out below on August 1953  
(Date)

since which time the water has been used continuously  
(Continuously or intermittently)

from June to September  
(Date) (Date)

4. Quantity of water claimed and used is 0 gallons per minute; \_\_\_\_\_ acre feet per year.

5. Purpose or Purposes for which water is used Irrigation

(Domestic, irrigation, municipal, manufacturing, industrial, etc.)

6. Description of Well: Depth 21 feet. Type Driven  
(Dug or drilled)

diameter 3 inches. Elevation of ground at well site \_\_\_\_\_ feet, mean sea level.  
(As near as known)

Depth to water table \_\_\_\_\_ feet.

7. Capacity of Well: \_\_\_\_\_ g.p.m. with \_\_\_\_\_ feet drawdown.

\_\_\_\_\_ g.p.m. with \_\_\_\_\_ feet drawdown.

Date of test Not Tested

If Flowing Well: Measured discharge \_\_\_\_\_ g.p.m. on \_\_\_\_\_  
(Date)


Shut-in pressure at ground surface \_\_\_\_\_ lbs. per sq. in. on \_\_\_\_\_  
(Date)

Water is controlled by \_\_\_\_\_  
(Cap, valve, etc.)





Township 16S Range 4W W.M.  
North

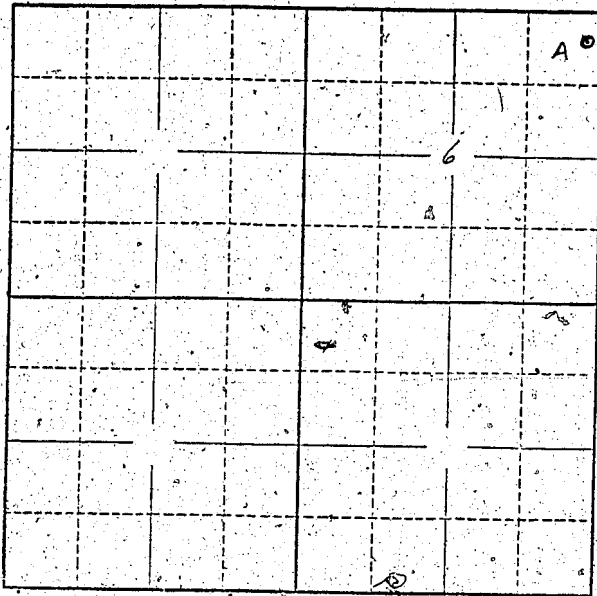

Locate well and acreage of irrigated land on plat.  
Scale: 2" = 1 Mile

STATE OF OREGON }  
County of Lane } ss.

Isabel C. Boy, being first duly sworn, do hereby certify that I have read the foregoing Registration Statement and that all of the items therein contained are true to the best of my knowledge and belief.

[Signature]  
(Signature of Registrant)

Subscribed and sworn to before me this 27<sup>th</sup> day of June, 1958

My commission expires June 16, 1959  
(Notary Public)

(SEAL)

**CERTIFICATE OF REGISTRATION**

STATE OF OREGON }  
County of Marion } ss.

This is to certify that the foregoing Registration Statement was received in the office of the State Engineer on the 31 day of July, 1958, at 5:00 o'clock A. M. and has been duly recorded in said office in Book No. 13 of Registration Statements on page GR-3148

Witness my hand this 16<sup>th</sup> day of June, 1959

[Signature]  
(State Engineer)

By \_\_\_\_\_  
(Deputy)

\$15.00

GR - 3148