

Registration Statement

OF CLAIMANT OF RIGHT TO APPROPRIATE GROUND WATER

(Under Chapter 708, Oregon Laws 1955.)

TO THE STATE ENGINEER OF OREGON:

I, Al Rings for Gervais Union High School Dist. #1, Marion County,
of Marion County of Gervais

State of Oregon do hereby make application for a certificate of registration as evidence of a right to appropriate ground water.

1. Source from which water is withdrawn is pump well
(Flowing well, pump well, infiltration trench, or tunnel)

2. Location is: 327 feet east of Gervais
(Approximate distance and direction from nearest city or town)

and is more particularly described as follows:

(a) Sec. 1, C.R. Map - 1850 feet west & 1640 feet north from S.E. Corner
(Give distance and bearing to corner of section or other legal subdivision)

being within 1/4 of Sec. 24, Twp. 5 S, Rge. 2 W
(Smallest legal subdivision) (N. or S.) (E. or W.)

or (b) within limits of recorded platted property, town or city:

in Lot _____ Block _____ of _____
(Name of plat or addition)

County of _____
(If within city or town, give name)

3. Construction Work was begun on June 2, 1953; was completed on July 11, 1953
(Date) (Date)

and the ground water claimed was first used for the purposes set out below on July 11, 1953
(Date)

since which time the water has been used Continuously
(Continuously or intermittently)

from July 1953 to July 1955
(Date) (Date)

4. Quantity of water claimed and used is 120 gallons per minute; _____ acre feet per year.

5. Purpose or Purposes for which water is used Irrigation and domestic use on ten acre school farm
(Domestic, irrigation, municipal, manufacturing, industrial, etc.)

6. Description of Well: Depth 120 feet. Type Dug
(Dug or drilled)

diameter 24 inches. Elevation of ground at well site 2851 feet, mean sea level.
(As near as known)

Depth to water table _____ feet.

7. Capacity of Well: _____ g.p.m. with 54 feet drawdown.

_____ g.p.m. with 86 feet drawdown.

Date of test June 11, 1953

If Flowing Well: Measured discharge _____ g.p.m. on _____
(Date)

Shut-in pressure at ground surface _____ lbs. per sq. in. on _____
(Date)

Water is controlled by _____
(Cap, valve, etc.)

8. Casing: (Give diameter, commercial specifications and depth below ground surface of each casing size.)

2 5/8 inch diameter casing, welded joints from 0 to 123 feet
 inch diameter from to feet
 inch diameter from to feet
 inch diameter from to feet

Describe and show depth of shoe, plug, adapter, liner or other details:

9. Perforated Casings or Screens:

Mills Perforator, 17 rows, 3 to a row from 56 to 110
 (Number per foot and size of perforations, or describe screen)
 Mills perforator, 2 rows, 8 to a row from 111 to 113
 from to
 from to

10. Log of Well: (Describe each stratum or formation clearly, indicate if water bearing, and give thickness and depth as indicated.)

MATERIAL	Thickness (Feet)	Depth to Bottom (Feet)
Top soil and yellow silty subsoil	2	2
Blue Shale	25	27
Black sand (some shale)	70	97
Blue Shale	50	147
Brown Shale (hard)	27	174
Water bearing sand and gravel	112	286
Brown shale & gravel (hard)	101	387
Blue shale & gravel	127	514
Sand & gravel (light formation)	18	532

If log of well is not available, give name and address of driller.

11. Infiltration Trench: Covered or open

Dimensions: Length ft. Minimum depth ft. Maximum depth ft.
Bottom width ft. Discharge g.p.m. Date of test

12. Tunnel: Type of lining

Dimensions:
(Length, course, and cross sectional size).
Position of water bearing stratum with reference to portal of tunnel

Log of tunnel: (Preceding table for log of well may be used, if desired. Give footage from portal and character of materials, as pertinent.)

13. Pumping Equipment:


Pearless machine, Ser. No. 141712 3 1/2 Column, 3 stages of
(a) Pump Capacity g.p.m.
(Make, type and size)
(b) Motor H. P.
(Type and horsepower)

14. Location of area irrigated or to be irrigated, or place of use if for purposes other than irrigation.

Township North or South	Range E. or W. of Willamette Meridian	Section	Forty-acre Tract	Number Acres To Be Irrigated	Date of Reclamation
	2 W	26	A. C. P. Map		1953

15. If the ground water supply is supplemental to an existing water supply, identification of any application for a permit, permit, certificate or adjudicated right to appropriate water made or held by the registrant.

Township 5S Range 2W, W.M.
North

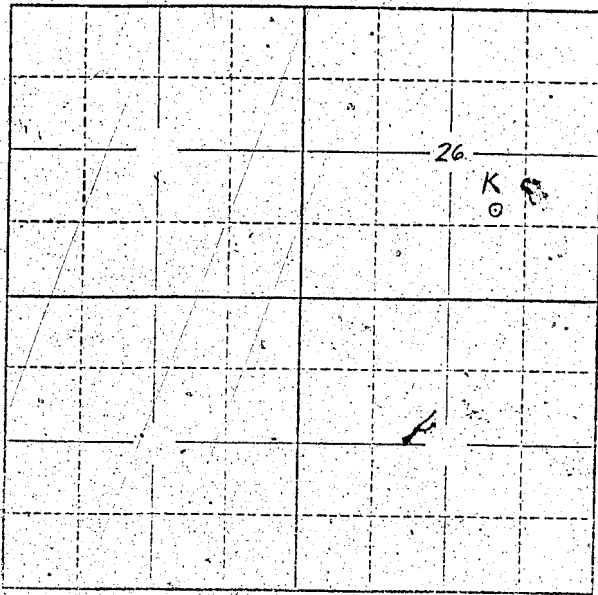

Locate well and acreage of irrigated land on plat.
Scale: 2" = 1 Mile

STATE OF OREGON

County of Marion } ss.

I, Al Ring, being first duly sworn, do hereby certify that I have read the foregoing Registration Statement and that all of the items therein contained are true to the best of my knowledge and belief.

Al Ring
(Signature of Registrant)

Subscribed and sworn to before me this 29th day of July, 1958

My commission expires 8-22-61 W. G. Madson
(Notary Public)

(SEAL)

CERTIFICATE OF REGISTRATION

STATE OF OREGON

County of Marion } ss.

This is to certify that the foregoing Registration Statement was received in the office of the State Engineer on the 31st day of July, 1958, at 11:00 o'clock A.M. and has been duly recorded in said office in Book No. 13 of Registration Statements on page GR:3150

Construction shall be completed by 10 and the water completely applied to the land by 10

Witness my hand this 16th day of June, 1959

W. G. Madson
(State Engineer)

By _____ (Deputy)

GR-3150

\$15.00