

Registration Statement

OF CLAIMANT OF RIGHT TO APPROPRIATE GROUND WATER

TO THE STATE ENGINEER OF OREGON:

I, CLIFFORD-E-PULLEN

of Cave Junction
(Mailing address)

County of Josephine

State of Oregon, do hereby make application for a certificate of registration as evidence of a right to appropriate ground water.

1. Source from which water is withdrawn is Pump well
(Flowing well, pump well, infiltration trench, or tunnel)

2. Location is: Six miles from Cave Junction
(Approximate distance and direction from nearest city or town)

and is more particularly described as follows: 1550' east & 700' south from NW Cor. Sec. 6,

(a) 500 ft from S-W corner
(Give distance and bearing to corner of section or other legal subdivision)

being within N.E. 1/4 W.W. of Sec. 6, Twp. 40, Rge. 7
(Smallest legal subdivision) (N. or S.) (E. or W.)

or (b) within limits of recorded platted property, town or city: X

in Lot X, Block X of X
(Name of plat or addition)

X County of X
(If within city or town, give name)

3. Construction Work was begun on 1947; was completed on 1947
(Date) (Date)

and the ground water claimed was first used for the purposes set out below on 1947

since which time the water has been used Continuously
(Continuously or Intermittently)

from 1947 to 1958
(Date) (Date)

4. Quantity of water claimed and used is 1.75 gallons per minute, 10 1/4 acre feet per year.

5. Purpose or Purposes for which water is used Irrigation

(Domestic, irrigation, municipal, manufacturing, industrial, etc.)

6. Description of Well: Depth 15 ft feet. Type Dug
(Dug or drilled)

diameter 12 ft inches. Elevation of ground at well site 1300 feet, mean sea level.
(As near as known)

Depth to water table 7 ft feet.

7. Capacity of Well: 250 g.p.m. with 3 ft feet drawdown.

g.p.m. with _____ feet drawdown.


Date of test: 1950

If Flowing Well: Measured discharge X g.p.m. on X
(Date)

Shut-in pressure at ground surface X lbs. per sq. in. on X
(Date)

Water is controlled by X
(Cap, valve, etc.)

Township 405 Range 7W, W.M.
North

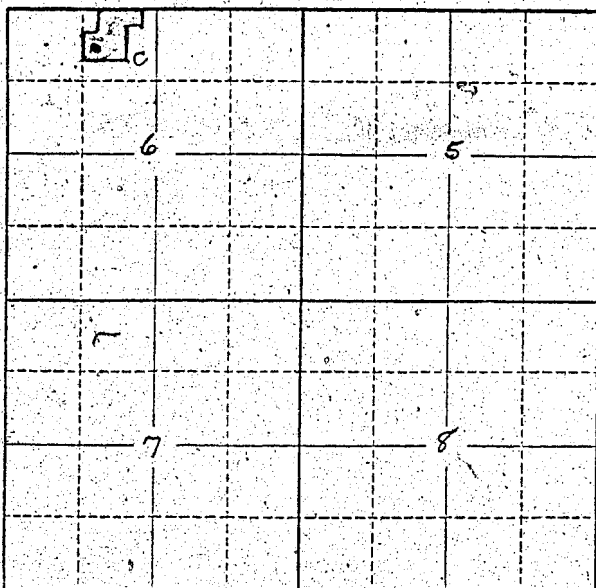

Locate well and acreage of irrigated land on plat.
Scale: 2" = 1 Mile

STATE OF OREGON

County of Josephine } ss.

I, Clifford E. Pullen, being first duly sworn, do hereby certify that I have read the foregoing Registration Statement and that all of the items therein contained are true to the best of my knowledge and belief.

Clifford E. Pullen
(Signature of Registrant)

Subscribed and sworn to before me this 29 day of July, 19 58

My commission expires Feb. 7, 1962

Gray R. Hussey
(Notary Public)

(SEAL)

CERTIFICATE OF REGISTRATION

STATE OF OREGON

County of Marion } ss.

This is to certify that the foregoing Registration Statement was received in the office of the State Engineer on the 31st day of July, 19 58, at 8:00 o'clock A.M. and has been duly recorded in said office in Book No. 13 of Registration Statements on page GR-3158

Witness my hand this 18th day of June, 19 59

Lewis A. Stanley
(State Engineer)

By _____ (Deputy)

#15.00

GR-3158