RECEIVED
JAN 13 1957
STATE ENGINEER
SALEM, OREGON

REGISTRATION NO. GR-341

CERTIFICATE NO. GR-326

Registration Statement

OF CLAIMANT OF RIGHT TO APPROPRIATE GROUND WATER

(Under Chapter 708, Oregon Laws 1955.)

TO THE STATE ENGINEER OF OREGON:

I, Roy R. Stoutenburg Rt 1, Box 107, Dayton,

of Yamhill County of Dayton

State of Oregon, do hereby make application for a certificate of registration as evidence of a right to appropriate ground water.

1. **Source** from which water is withdrawn is Pump well
(Flowing well, pump well, infiltration trench, or tunnel)

2. **Location** is: Grand Island, 10 miles south of Dayton, Oregon;
(Approximate distance and direction from nearest city or town)

and is more particularly described as follows:

(a) 1500' W & 1800' N from SE corner
(Give distance and bearing to corner of section or other legal subdivision)

being within NE ¼ SE ¼ of Sec. 10, Twp. 5S, Rge. 3W
(Smallest legal subdivision) (N. or S.) (E. or W.)

or (b) within limits of recorded platted property, town or city:

in Lot ....., Block ..... of .....
(Name of plat or addition)

..... County of .....
(If within city or town, give name)

3. **Construction Work** was begun on July 1941 (Date); was completed on July 1941 (Date)

and the ground water claimed was first used for the purposes set out below on July (Date),

since which time the water has been used Continuously
(Continuously or intermittently)

from 1942 (Date) to 1956 (Date)

4. **Quantity** of water claimed and used is 270 gallons per minute; ..... acre feet per year.

5. **Purpose or Purposes** for which water is used Irrigation
(Domestic, irrigation, municipal, manufacturing, industrial, etc.)

6. **Description of Well:** Depth 20 feet. Type drilled
(Dug or drilled)

diameter 12 inches. Elevation of ground at well site 90 feet, mean sea level.
(As near as known)

Depth to water table 4 feet.

7. **Capacity of Well:** 350 g.p.m. with 15 feet drawdown.

..... g.p.m. with ..... feet drawdown.

Date of test .....

If Flowing Well: Measured discharge ..... g.p.m. on .....
(Date)

Shut-in pressure at ground surface ..... lbs. per sq. in. on .....
(Date)

Water is controlled by .....
(Cap, valve, etc.)

8. **Casing:** (Give diameter, commercial specifications and depth below ground surface of each casing size.)

10 inch diameter from top to bottom feet

inch diameter from to feet

inch diameter from to feet

inch diameter from to feet

Describe and show depth of shoe, plug, adapter, liner or other details: 18 ft. suction pipe with foot valve at bottom.

9. **Perforated Casings or Screens:**

1st eight ft. parforated; perforations 4 x ½ in. from to
(Number per foot and size of perforations, or describe screen)

from to

from to

from to

10. **Log of Well:** (Describe each stratum or formation clearly, indicate if water bearing, and give thickness and depth as indicated.)

MATERIAL	Thickness (Feet)	Depth to Bottom (Feet)
top soil	4 ft.	16 ft.
gravel	16 ft.	

GR-326 A

If log of well is not available, give name and address of driller. Fred Wymore, Brooks, Oregon.

11. **Infiltration Trench:** Covered or open .....

Dimensions: Length ..... ft. Minimum depth ..... ft. Maximum depth ..... ft.

Bottom width ..... ft. Discharge ..... g.p.m. Date of test .....

12. **Tunnel:** Type of lining .....

Dimensions: .....
(Length, course, and cross sectional size)

Position of water bearing stratum with reference to portal of tunnel .....

Log of tunnel: (Preceding table for log of well may be used, if desired. Give footage from portal and character of materials, as pertinent.)

13. **Pumping Equipment:**

(a) Pump 2 in. Pump with FB motor 7½ hp. (Make, type and size) Capacity 300 g.p.m.

(b) Motor .....
(Type and horsepower)

14. Location of area irrigated or to be irrigated, or place of use if for purposes other than irrigation.

Township North or South	Range E. or W. of Willamette Meridian	Section	Forty-acre Tract	Number Acres To Be Irrigated	Date of Reclamation
5 S	3 W	10		50	1941
"	"	"	SE¼ NE¼	5	"
"	"	"	SW ¼ NE¼	3	"
"	"	"	NE ¼ SE¼	22	"
"	"	"	SE ¼ SE¼	10	"
"	"	"	SW SE	4	"
"	"	"	NE SE	6	"
			Total	50	

15. If the ground water supply is supplemental to an existing water supply, identification of any application for a permit, permit, certificate or adjudicated right to appropriate water made or held by the registrant.

.....

.....

GR-326 B

Township 5 S Range 3 W, W.M.

North

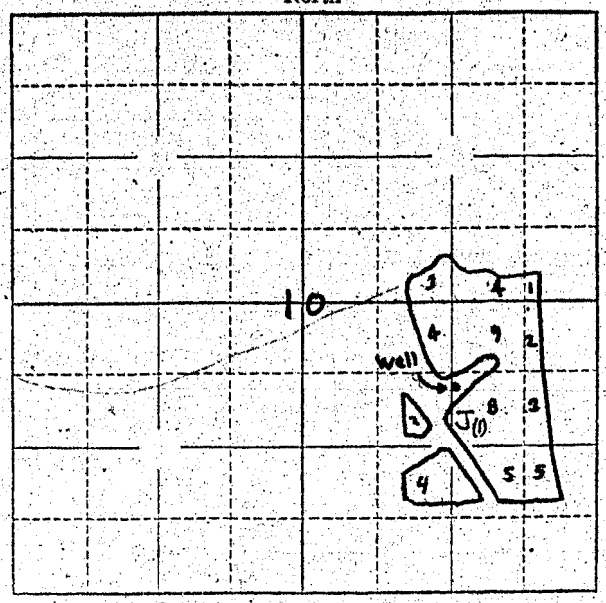

Locate well and acreage of irrigated land on plat.

Scale: 1/4" = 1 Mile

STATE OF OREGON
County of Yamhill } ss.

I, Roy E. Stoutenburg, being first duly sworn, do hereby certify that I have read the foregoing Registration Statement and that all of the items therein contained are true to the best of my knowledge and belief.

Roy E. Stoutenburg
(Signature of Registrant)

Subscribed and sworn to before me this 15th day of January 19 57.

My commission expires May 23, 1960

Kenneth N. Lomery
(Notary Public)

(SEAL)

CERTIFICATE OF REGISTRATION

STATE OF OREGON
County of Marion } ss.

This is to certify that the foregoing Registration Statement was received in the office of the State Engineer on the 18th day of January, 19 57 at 8:00 o'clock A. M. and has been duly recorded in said office in Book No. 2 of Registration Statements on page GR-326 C

~~Construction shall be completed by x-x-x-x-x-x-x-x-x-x, 19x-x, and the water completely applied to beneficial use by x-x-x-x-x-x-x-x-x-x 19-x-x-~~

Witness my hand this 1st day of April, 19 57.

Lewis A. Stanley
(State Engineer)

$18.00

By
(Deputy)

GR-326 C