

Registration Statement CERTIFICATE NO. GR-3934

RECEIVED
JUL 31 1953
RECEIVED
JAN 25 1961
STATE ENGINEER
SALE

OF CLAIMANT OF RIGHT TO APPROPRIATE GROUND WATER

(Under Chapter 708, Oregon Laws 1955.)

TO THE STATE ENGINEER OF OREGON:

I, MERWYN J. THOMPSON

of Springfield Ore R1 Box 40 County of Lane

State of Oregon, do hereby make application for a certificate of registration as evidence of a right to appropriate ground water.

1. Source from which water is withdrawn is DUG WELL
(Flowing well, pump well, infiltration trench, or tunnel)

2. Location is: 2 MILES FROM SPRINGFIELD
(Approximate distance and direction from nearest city or town)

and is more particularly described as follows:

(a) LOCATED 315 FT NORTH FROM S. E CORNER ON E. LINE OF
(Give distance and bearing to corner of section or other legal subdivision)

being within NW 1/4 of SW 1/4 of Sec. 19 Twp. 17 S Rge. 2 W
(Smallest legal subdivision) (T. or S.) (R. or W.)

or (b) within limits of recorded platted property, town or city:

in Lot 10A Block 1 of LANE
(Name of plat or addition)

County of LANE
(If within city or town; give name)

3. Construction Work was begun on OCTOBER 1939, was completed on OCT 20 1939
(Date) (Date)

and the ground water claimed was first used for the purposes set out below on JUNE 1 1940
(Date)

since which time the water has been used CONTINUOUSLY
(Continuously or intermittently)

from May 1 to Oct 1
(Date) (Date)

4. Quantity of water claimed and used is 90 gallons per minute; 0 acre feet per year.

5. Purpose or Purposes for which water is used IRRIGATION

(Domestic, irrigation, municipal, manufacturing, industrial, etc.)

6. Description of Well: Depth 14 1/2 feet. Type DUG WELL
(Dug or drilled)

diameter 48" X 60" inches. Elevation of ground at well site 0 feet, mean sea level.
(As near as known)

Depth to water table 8 ft appx

7. Capacity of Well: 90 g.p.m. with 3 feet drawdown.

90 g.p.m. with 6 feet drawdown. late season

Date of test Sept 15 - 1957
runs out sometimes


If Flowing Well: Measured discharge 0 g.p.m. on 0 (Date)

Shut-in pressure at ground surface 0 lbs. per sq. in. on 0 (Date)

Water is controlled by 0
(Cap, valve, etc.)

Section 17 Township 17S Range 2W, W.M.

North

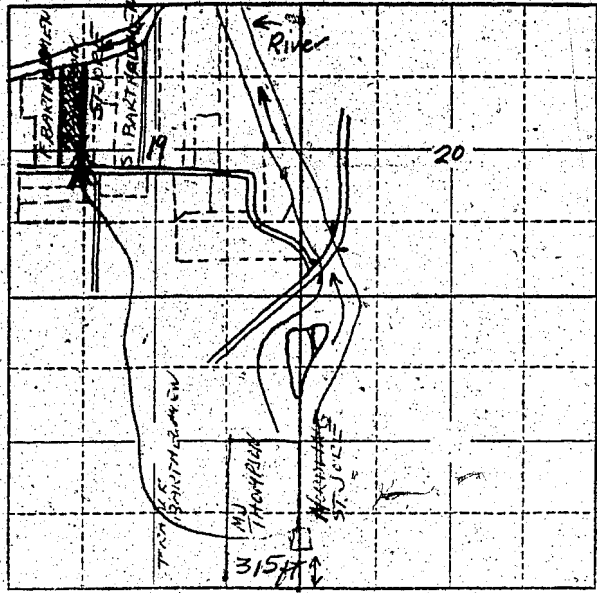

Well is located on the East line of my property appx 315 ft from property line beginning at Douglas Bridge Road.

Locate well and acreage of irrigated land on plat.

Scale: 2" = 1 Mile

STATE OF OREGON

County of LANE } ss:

I, MARIE J. ROSS, being first duly sworn, do hereby certify that I have read the foregoing Registration Statement and that all of the items therein contained are true to the best of my knowledge and belief.

Marjorie J. Ross
(Signature of Registrant)

Subscribed and sworn to before me this 28th day of July, 1958

My commission expires 2-3-61

Marie J. Ross
(Notary Public)

(SEAL)

CERTIFICATE OF REGISTRATION

STATE OF OREGON

County of Marion } ss.

This is to certify that the foregoing Registration Statement was received in the office of the State Engineer on the 31 day of July, 1958, at 8:00 clock A.M., and has been duly recorded in said office in Book No. 16 of Registration Statements on page GR-3934

~~Construction shall be completed by 1959 and the water completed applied to beneficial use by 1960~~

Witness my hand this 15th day of February, 1960

Laura A. Stanley
(State Engineer)

7.15.00

By (Deputy)

GR-3934