

Registration Statement

OF CLAIMANT OF RIGHT TO APPROPRIATE GROUND WATER

TO THE STATE ENGINEER OF OREGON:

I, Crawford Brothers

of Route 3, Box 547, Corvallis County of Benton
(Mailing address)

State of Oregon, do hereby make application for a certificate of registration as evidence of a right to appropriate ground water.

1. Source from which water is withdrawn is pump well # 1
(Flowing well, pump well, infiltration trench, or tunnel)

2. Location is: 10 miles south of Corvallis
(Approximate distance and direction from nearest city or town)

and is more particularly described as follows: S 49° 45' W 680' to SW corner of property, said
9 600 feet South & 500 feet East from Center Section 13

(a) corner being on the west line of the NW 1/4 SE 1/4, Sec. 24, T. 13S., R. 5W., W.M., well
(Give distance and bearing to corner of section or other legal subdivision)

being within NW 1/4 SE 1/4 of Sec. 13, Twp. 13S, Rge. 5W
(Smallest legal subdivision) (N. or S.) (E. or W.)

or (b) within limits of recorded platted property, town or city:

in Lot _____, Block _____ of _____
(Name of plat or addition)

(If within city or town, give name) _____ County of _____

3. Construction Work was begun on 1949; was completed on 1949
(Date) (Date)

and the ground water claimed was first used for the purposes set out below on 1949
(Date)

since which time the water has been used continuously
(Continuously or intermittently)

from 1949 to 1958
(Date) (Date)

4. Quantity of water claimed and used is 120 when pumping gallons per minute; 40 acre feet per year.

5. Purpose or Purposes for which water is used irrigation

(Domestic, irrigation, municipal, manufacturing, industrial, etc.)

6. Description of Well: Depth 32 feet, Type drilled & dug
(Dug or drilled)

diameter 4 inches. Elevation of ground at well site 250 feet, mean sea level.
(As near as known)

Depth to water table 12 feet.

7. Capacity of Well: 4-500 g.p.m. with none feet drawdown.

_____ g.p.m. with _____ feet drawdown.

Date of test never tested

If Flowing Well: Measured discharge _____ g.p.m. on _____
(Date)

Shut-in pressure at ground surface _____ lbs. per sq. in. on _____
(Date)

Water is controlled by _____
(Cap, valve, etc.)

8. Casing: (Give diameter, commercial specifications and depth below ground surface of each casing size.)

..... inch diameter 4' x 4' dug pit from surface to 5 feet
4 inch diameter steel casing from 5' to 32' feet
..... inch diameter from to feet
..... inch diameter from to feet

Describe and show depth of shoe, plug, adapter, liner or other details:

9. Perforated Casings or Screens:

perforated from 24 to 32'
(Number per foot and size of perforations, or describe screen)
..... from to
..... from to
..... from to

10. Log of Well: (Describe each stratum or formation clearly, indicate if water bearing, and give thickness and depth as indicated.)

MATERIAL	Thickness (Feet)	Depth to Bottom (Feet)
unknown		

If log of well is not available, give name and address of driller. Frank Skillings, Philomath

11. Infiltration Trench: Covered or open

Dimensions: Length ft. Minimum depth ft. Maximum depth ft.

Bottom width ft. Discharge g.p.m. Date of test

12. Tunnel: Type of lining

Dimensions:
(Length, course, and cross sectional size)

Position of water bearing stratum with reference to portal of tunnel

Log of tunnel: (Preceding table for log of well may be used, if desired. Give footage from portal and character of materials, as pertinent.)

13. Pumping Equipment:

(a) Pump 1 1/2 x 1 1/2 centrifugal Capacity 200 g.p.m.
(Make, type and size)


(b) Motor 5 hp electric, single phase
(Type and horsepower)

14. Location of area irrigated or to be irrigated, or place of use if for purposes other than irrigation.

Township North or South	Range E. or W. of Willamette Meridian	Section	Forty-acre Tract	Number Acres To Be Irrigated	Date of Reclamation
13S	5W	24	NW 1/4 SE 1/4	13.0	19 <u>4</u> 49
13S	5W	24	NE 1/4 SE 1/4	5.0	19 <u>4</u> 49
13S	5W	24	NE 1/4 SE 1/4	12.0 *	19 <u>4</u> 49
Total				30.0	1949
* Refer to item 15					

15. If the ground water supply is supplemental to an existing water supply, identification of any application for a permit, permit, certificate or adjudicated right to appropriate water made or held by the registrant. 12 acres as noted is irrigated from this well occasionally because electric power is available. Most of the time it is irrigated from another nearby well being filed upon currently.

Township 13S Range 5W, W.M.
North

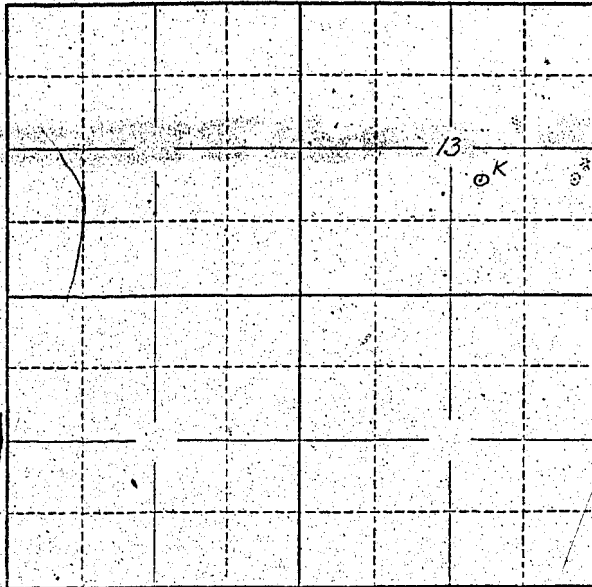

Locate well and acreage of irrigated land on plat.
Scale: 2" = 1 Mile

STATE OF OREGON

County of Benton } ss.

I, Robert J. Lane Ford, being first duly sworn, do hereby certify that I have read the foregoing Registration Statement and that all of the items therein contained are true to the best of my knowledge and belief.

Robert J. Lane Ford
(Signature of Registrant)

Subscribed and sworn to before me this 30th day of July, 1955.

My commission expires Feb. 14, 1961
(Notary Public)

(SEAL)

CERTIFICATE OF REGISTRATION

STATE OF OREGON } ss.
County of Marion

This is to certify that the foregoing Registration Statement was received in the office of the State Engineer on the 31 day of July, 1955, at 8:00 o'clock A. M. and has been duly recorded in said office in Book No. 13 of Registration Statements on page GR-3159

Witness my hand this 18th day of June, 1959

Lewis A. Stanley
(State Engineer)

By _____ (Deputy)

GR - 3159

\$15.00