

# Registration Statement

## OF CLAIMANT OF RIGHT TO APPROPRIATE GROUND WATER

TO THE STATE ENGINEER OF OREGON:

I, Ed and Luella Ferrill

of 1515 E. Chemawa Rd. SALEM County of Marion  
(Mailing address)

State of Oregon do hereby make application for a certificate of registration as evidence of a right to appropriate ground water.

1. Source from which water is withdrawn is pump well  
(Flowing well, pump well, infiltration trench, or tunnel)

2. Location is: 4 mi. N. of Salem, Ore.  
(Approximate distance and direction from nearest city or town)

and is more particularly described as follows: 2200 feet west & 500 feet south from NE corner Section 2

(a) Lot 18 Claggett Fruit and Garden Tracts  
(Give distance and bearing to corner of section or other legal subdivision)

being within NW 1/4 of NE 1/4 of Sec. 2, Twp. 7 S, Rge. 7  
(Smallest legal subdivision) (or S.) (or W.)

or (b) within limits of recorded platted property, town or city:

in Lot \_\_\_\_\_, Block \_\_\_\_\_ of \_\_\_\_\_  
(Name of plat or addition)

\_\_\_\_\_ County of \_\_\_\_\_  
(If within city or town, give name)

3. Construction Work was begun on about 1930; was completed on same year  
(Date) (Date)

and the ground water claimed was first used for the purposes set out below on about 1930  
(Date)

since which time the water has been used continuously  
(Continuously or intermittently)

from 1930 to present time  
(Date) (Date)

4. Quantity of water claimed and used is 30 gallons per minute; 7 acre feet per year.

5. Purpose or Purposes for which water is used irrigation  
(Domestic, irrigation, municipal, manufacturing, industrial, etc.)

6. Description of Well: Depth 40' feet. Type 6" pipe casing drilled  
(Dug or drilled)

diameter 6" inches. Elevation of ground at well site 500' feet, mean sea level.  
(As near as known)

Depth to water table 10' feet.

7. Capacity of Well: 30 g.p.m. with 0' feet drawdown.

3 g.p.m. with \_\_\_\_\_ feet drawdown.

Date of test when well was dug.

If Flowing Well: Measured discharge \_\_\_\_\_ g.p.m. on \_\_\_\_\_  
(Date)

Shut-in pressure at ground surface \_\_\_\_\_ lbs. per sq. in. on \_\_\_\_\_  
(Date)

Water is controlled by \_\_\_\_\_  
(Cap, valve, etc.)

8. Casing: (Give diameter, commercial specifications and depth below ground surface of each casing size.)

6 inch diameter steel casing from 0 to 4.0 feet  
 inch diameter from to feet  
 inch diameter from to feet  
 inch diameter from to feet

Describe and show depth of shoe, plug, adapter, liner or other details:  
 .....  
 .....

9. Perforated Casings or Screens:

not perforated from to  
 (Number per foot and size of perforations, or describe screen)  
 from to  
 from to  
 from to

10. Log of Well: (Describe each stratum or formation clearly, indicate if water bearing, and give thickness and depth as indicated.)

MATERIAL	Thickness (Feet)	Depth to Bottom (Feet)
do not know		

If log of well is not available, give name and address of driller.

Chester Pugh - Heavon

11. Infiltration Trench: Covered or open

Dimensions: Length ..... ft. Minimum depth ..... ft. Maximum depth ..... ft.

Bottom width ..... ft. Discharge ..... g.p.m. Date of test

12. Tunnel: Type of lining

Dimensions: ..... (Length, course, and cross sectional size)

Position of water bearing stratum with reference to portal of tunnel

Log of tunnel: (Preceding table for log of well may be used, if desired. Give footage from portal and character of materials, as pertinent.)

13. Pumping Equipment:

(a) Pump ..... Jacuzzi Pumps ..... Capacity 30 g.p.m.  
(Make, type and size)


(b) Motor ..... 5 hp. Electric  
(Type and horsepower)

14. Location of area irrigated or to be irrigated, or place of use if for purposes other than irrigation.

Township North or South	Range E. or W. of Willamette Meridian	Section	Forty-acre Tract	Number Acres To Be Irrigated	Date of Reclamation
T75	R3W	2	NW 1/4 of NE 1/4	6.0	1938

15. If the ground water supply is supplemental to an existing water supply, identification of any application for a permit, permit, certificate or adjudicated right to appropriate water made or held by the registrant.

Township 75 Range 3W W.M.  
North

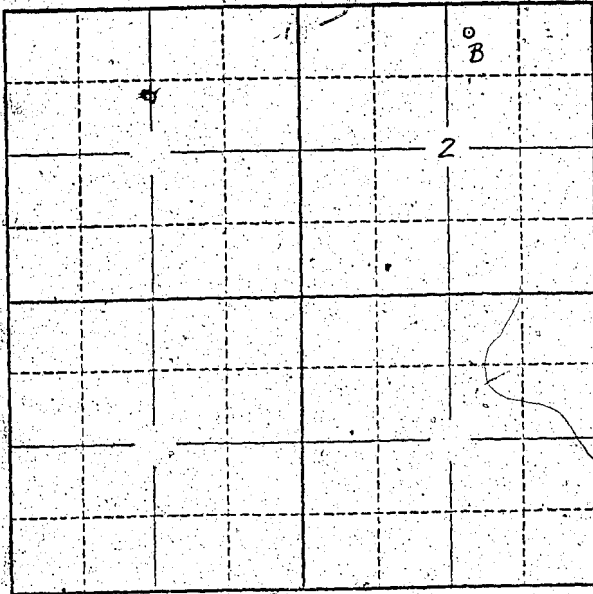

Locate well and acreage of irrigated land on plat:  
Scale: 2" = 1 Mile

STATE OF OREGON

County of Marion } ss.

I, Ed. Fennell, being first duly sworn, do hereby certify that I have read the foregoing Registration Statement and that all of the items therein contained are true to the best of my knowledge and belief.

Ed. Fennell  
(Signature of Registrant)

Subscribed and sworn to before me this 21 day of July, 1958  
My commission expires May 1st 1959 W. R. ...  
(Notary Public)

(SEAL)

**CERTIFICATE OF REGISTRATION**

STATE OF OREGON

County of Marion } ss.

This is to certify that the foregoing Registration Statement was received in the office of the State Engineer on the 31st day of July, 1958, at 1:15 o'clock P.M. and has been duly recorded in said office in Book No. 13 of Registration Statements on page GR-3161

Witness my hand this 19th day of June, 1959  
Laura A. ...  
(State Engineer)

\$15.00

By \_\_\_\_\_  
(Deputy)

GR 3161