

Registration Statement

OF CLAIMANT OF RIGHT TO APPROPRIATE GROUND WATER

TO THE STATE ENGINEER OF OREGON:

I, Loren K. and Helen J. Blacklay
of Rt. 2, Box 205, Lebanon County of Linn
(Mailing address)

State of Oregon, do hereby make application for a certificate of registration as evidence of a right to appropriate ground water.

1. Source from which water is withdrawn is Pump Well No. 1
(Flowing well, pump well, infiltration trench, or tunnel)

2. Location is: 4 miles northeast of Lebanon, Oregon
(Approximate distance and direction from nearest city or town)

and is more particularly described as follows:

(a) S. 30° 10' W. 27. chains from the NE corner of D10 57, T. 11 S., R. 2 E., N. 4
(Give distance and bearing to corner of section or other legal subdivision)

being within NE 1/4 of SE 1/4 of Sec. 26, Twp. 11 S., Rge. 2 E.
(Smallest legal subdivision) (N. or S.) (E. or W.)

or (b) within limits of recorded platted property, town or city:

in Lot _____, Block _____ of _____
(Name of plat or addition)

County of Linn
(If within city or town, give name)

3. Construction Work was begun on Aug. 1952; was completed on Aug. 1952
(Date) (Date)

and the ground water claimed was first used for the purposes set out below on June 1953
(Date)

since which time the water has been used continuously
(Continuously or intermittently)

from June 1953 to present time
(Date) (Date)

4. Quantity of water claimed and used is 300 gallons per minute; 17.5 acre feet per year.

5. Purpose or Purposes for which water is used Irrigation

(Domestic, irrigation, municipal, manufacturing, industrial, etc.)

6. Description of Well: Depth 25 feet. Type Drilled
(Dug or drilled)

diameter 10 inches. Elevation of ground at well site 307 feet, mean sea level.
(As near as known)

Depth to water table 15 feet.

7. Capacity of Well: 350 g.p.m. with 4 feet drawdown.

_____ g.p.m. with _____ feet drawdown.

Date of test Aug. 1953

If Flowing Well: Measured discharge _____ g.p.m. on _____
(Date)

Shut-in pressure at ground surface _____ lbs. per sq. in. on _____
(Date)

Water is controlled by _____
(Cap, valve, etc.)

8. Casing: (Give diameter, commercial specifications and depth below ground surface of each casing size.)

10 inch diameter steel casing from 0 to 25 feet
inch diameter from to feet
inch diameter from to feet
inch diameter from to feet

Describe and show depth of shoe, plug, adapter, liner or other details:

9. Perforated Casings or Screens:

Slot perforations from 19 to 25 feet
(Number per foot and size of perforations, or describe screen)
from to
from to
from to

10. Log of Well: (Describe each stratum or formation clearly, indicate if water bearing, and give thickness and depth as indicated.)

MATERIAL	Thickness (Feet)	Depth to Bottom (Feet)
Not available		

If log of well is not available, give name and address of driller. Bill Hamilton Drilling Co.,
838 East Third Ave., Albany, Oregon

11. Infiltration Trench: Covered or open
 Dimensions: Length ft. Minimum depth ft. Maximum depth ft.
 Bottom width ft. Discharge g.p.m. Date of test

12. Tunnel: Type of lining
 Dimensions:
(Length, course, and cross sectional size)
 Position of water bearing stratum with reference to portal of tunnel

Log of tunnel: (Preceding table for log of well may be used, if desired. Give footage from portal and character of materials, as pertinent.)


13. Pumping Equipment:
 (a) Pump 2 1/2" centrifugal Capacity 300 g.p.m.
(Make, type and size)
 (b) Motor 10 H. P. electric
(Type and horsepower)

14. Location of area irrigated or to be irrigated, or place of use if for purposes other than irrigation.

Township North or South	Range E. or W. of Willamette Meridian	Section	Forty-acre Tract	Number Acres To Be Irrigated	Date of Reclamation
11 S	2 W	26	NE 1/4 of SE 1/4	7.0	June 1953

15. If the ground water supply is supplemental to an existing water supply, identification of any application for a permit, permit, certificate or adjudicated right to appropriate water made or held by the registrant.

Township 11 S Range 2 W, W.M.
North

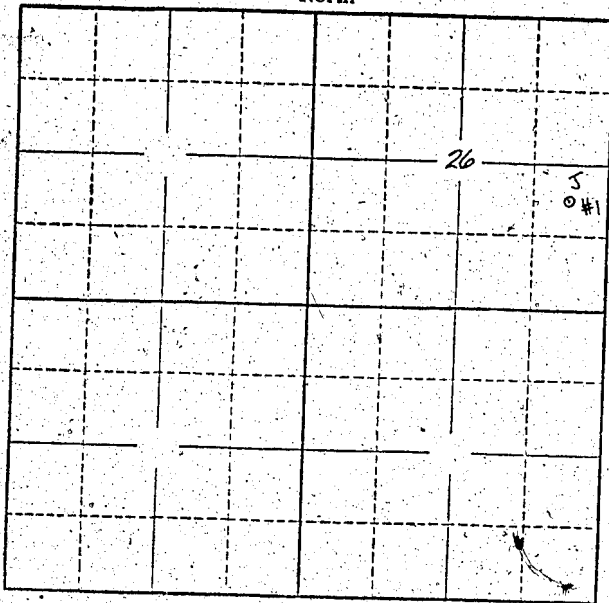

MAP IN G-1132

Locate well and acreage of irrigated land on plat.
Scale: 2" = 1 Mile

STATE OF OREGON

County of LINN

ss.

I, Loren W. and Helen J. Blacklaw, being first duly sworn, do hereby certify that I have read the foregoing Registration Statement and that all of the items therein contained are true to the best of my knowledge and belief.

Loren W. Blacklaw
Helen J. Blacklaw
(Signature of Registrant)

Subscribed and sworn to before me this 16 day of July, 1959

My commission expires 7/22/61
(Notary Public)

(SEAL)

CERTIFICATE OF REGISTRATION

STATE OF OREGON

County of Marion

ss.

This is to certify that the foregoing Registration Statement was received in the office of the State Engineer on the 30 day of July, 1959, at 4 o'clock P.M. and has been duly recorded in said office in Book No. 13 of Registration Statements on page GR-3162

Witness my hand this 18th day of June, 1959

#1500

Lewis A. Stanley
(State Engineer)

By _____ (Deputy)

GR - 3162