

Registration Statement

OF CLAIMANT OF RIGHT TO APPROPRIATE GROUND WATER



TO THE STATE ENGINEER OF OREGON:

I, Loretta Helen J. Blacklaw

of Rt. 2, Box 205, Lebanon County of Linn

State of Oregon, do hereby make application for a certificate of registration as evidence of a right to appropriate ground water.

1. Source from which water is withdrawn is Pump well No. 2
(Flowing well, pump well, infiltration trench, or tunnel)

2. Location is: 4 miles northeast of Lebanon, Oregon
(Approximate distance and direction from nearest city or town)

and is more particularly described as follows:

(a) S 8° 40' E. 9.5 chains from NE corner of DIC 57, T. 11 S. R. 2 W.
(Give distance and bearing to corner of section or other legal subdivision)
being within SE 1/4 of NE 1/4 of Sec. 40, Twp. 11 S., Rge. 2 W.
(Smallest legal subdivision) (N, or S.) (E. or W.)

or (b) within limits of recorded platted property, town or city:

in Lot _____, Block _____ of _____
(Name of plat or addition)
County of Linn
(If within city or town, give name)

3. Construction Work was begun on June 1950; was completed on June 1950
(Date) (Date)

and the ground water claimed was first used for the purposes set out below on June 1950
(Date)

since which time the water has been used continuously
(Continuously or Intermittently)

from June 1950 to present time
(Date) (Date)

4. Quantity of water claimed and used is 300 gallons per minute; 30.5 acre feet per year.

5. Purpose or Purposes for which water is used Irrigation
(Domestic, irrigation, municipal, manufacturing, industrial, etc.)

6. Description of Well: Depth 25 feet. Type Drilled
(Dug or drilled)
diameter 10 inches. Elevation of ground at well site _____ feet, mean sea level.
(As near as known)
Depth to water table 15 feet.

7. Capacity of Well: 500 g.p.m. with 3 feet drawdown.
_____ g.p.m. with _____ feet drawdown.


Date of test June 1950

If Flowing Well: Measured discharge _____ g.p.m. on _____
(Date)

Shut-in pressure at ground surface _____ lbs. per sq. in. on _____
(Date)

Water is controlled by _____
(Cap, valve, etc.)

Township 11 S Range 2 W W.M.
North

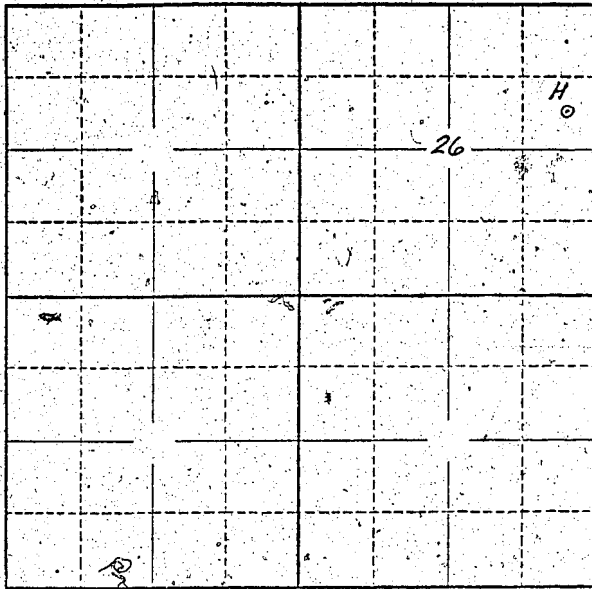

Map in
G-1132

Locate well and acreage of irrigated land on plat.
Scale: 2" = 1 Mile

STATE OF OREGON

County of LINN } ss.

I, Loren W. and Helen J. Blacklaw, being first duly sworn, do hereby certify that I have read the foregoing Registration Statement and that all of the items therein contained are true to the best of my knowledge and belief.

Loren W. Blacklaw
Helen J. Blacklaw

(Signature of Registrant)

Subscribed and sworn to before me this 16 day of July, 1928

My commission expires 11/23/31 *H. J. ...*

(Notary Public)

(SEAL)

CERTIFICATE OF REGISTRATION

STATE OF OREGON

County of Marion } ss.

This is to certify that the foregoing Registration Statement was received in the office of the State Engineer on the 16 day of July, 1928, at ... o'clock P.M. and has been duly recorded in said office in Book No. 13 of Registration Statements on page GR-3163

Witness my hand this 16th day of June, 1929

Lewis A. ...

(State Engineer)

By _____
(Deputy)

GR - 3163

\$15.00