

Registration Statement

OF CLAIMANT OF RIGHT TO APPROPRIATE GROUND WATER

TO THE STATE ENGINEER OF OREGON:

I, Loren W. and Helen J. Blacklaw

of Rt. 2, Box 205, Lebanon County of Linn

State of Oregon do hereby make application for a certificate of registration as evidence of a right to appropriate ground water.

1. Source from which water is withdrawn is Pump Well No. 3

2. Location is: 5 1/2 miles North of Lebanon, Oregon

and is more particularly described as follows:

(a) N. 42° 55' W. 9.3 chains from SE corner S. 15, T. 11 S, R. 2 W. 4. N.

being within SE 1/4 of SE 1/4 of Sec. 15, Twp. 11 S, Rge. 2

or (b) within limits of recorded platted property, town or city

in Lot _____, Block _____ of _____ County of Linn

3. Construction Work was begun on May 1949; was completed on May 1949

and the ground water claimed was first used for the purposes set out below on June 1949

since which time the water has been used continuously

from June 1949 to present time

4. Quantity of water claimed and used is 300 gallons per minute; 62.25 acre feet per year.

5. Purpose or Purposes for which water is used Irrigation

6. Description of Well: Depth 25 feet. Type Drilled

diameter 8 inches. Elevation of ground at well site 290 feet, mean sea level.

Depth to water table 16 feet.

7. Capacity of Well: 100 g.p.m. with 5 feet drawdown.

Date of test June 1949

If Flowing Well: Measured discharge _____ g.p.m. on _____

Shut-in pressure at ground surface _____ lbs. per sq. in. on _____

Water is controlled by _____

8. Casing: (Give diameter, commercial specifications and depth below ground surface of each casing size.)

8 inch diameter steel casing from 0 to 25 feet
inch diameter from to feet
inch diameter from to feet
inch diameter from to feet

Describe and show depth of shoe, plug, adapter, liner or other details:

9. Perforated Casings or Screens:

Slot perforations from 19 to 25
(Number per foot and size of perforations, or describe screen)
from to
from to
from to

10. Log of Well: (Describe each stratum or formation clearly, indicate if water bearing, and give thickness and depth as indicated.)

MATERIAL	Thickness (Feet)	Depth to Bottom (Feet)
Not available		

If log of well is not available, give name and address of driller. _____, _____, Oregon

11. Infiltration Trench: Covered or open _____

Dimensions: Length _____ ft. Minimum depth _____ ft. Maximum depth _____ ft.

Bottom width _____ ft. Discharge _____ g.p.m. Date of test _____

12. Tunnel: Type of lining _____

Dimensions: _____
(Length, course, and cross sectional size)

Position of water bearing stratum with reference to portal of tunnel _____

Log of tunnel: (Preceding table for log of well may be used, if desired. Give footage from portal and character of materials, as pertinent.)

13. Pumping Equipment:

(a) Pump Fairbanks Morse 3" cent. _____ Capacity 300 _____ g.p.m.
(Make, type and size)


(b) Motor 15 H. P. electric _____
(Type and horsepower)

14. Location of area irrigated or to be irrigated, or place of use if for purposes other than irrigation.

Township North or South	Range E. or W. of Willamette Meridian	Section	Forty-acre Tract	Number Acres To Be Irrigated	Date of Reclamation
11 S	2 W	14	SW $\frac{1}{4}$ of SW $\frac{1}{4}$	1.2	June 1919
11 S	2 W	15	SE $\frac{1}{4}$ of SE $\frac{1}{4}$	18.0	" "
11 S	2 W	22	NE $\frac{1}{4}$ of NE $\frac{1}{4}$	5.3	" "
11 S	2 W	23	NW $\frac{1}{4}$ of NW $\frac{1}{4}$	0.1	" "
				24.9	

15. If the ground water supply is supplemental to an existing water supply, identification of any application for a permit, permit, certificate or adjudicated right to appropriate water made or held by the registrant.

Township 11 S Range 2 W W.M.
North

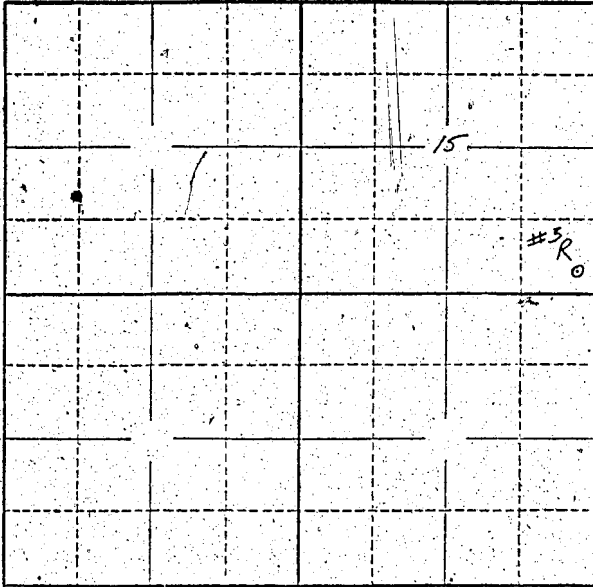

Locate well and acreage of irrigated land on plat.
Scale: 2" = 1 Mile

STATE OF OREGON

County of LINN

ss.

I, Loren W. and Helen J. Blacklar, being first duly sworn, do hereby certify that I have read the foregoing Registration Statement and that all of the items therein contained are true to the best of my knowledge and belief.

Loren W. Blacklar
Helen J. Blacklar
(Signature of Registrant)

Subscribed and sworn to before me this 15 day of July, 1958

My commission expires Apr 25, 1961

W. A. Smith
(Notary Public)

(SEAL)

CERTIFICATE OF REGISTRATION

STATE OF OREGON

County of Marion

ss.

This is to certify that the foregoing Registration Statement was received in the office of the State Engineer on the 30 day of July, 1958, at 8:00 o'clock P.M. and has been duly recorded in said office in Book No. 13 of Registration Statements on page GR-3164

Witness my hand this 18th day of June, 1959

Lewis A. Smith
(State Engineer)

By _____ (Deputy)

\$15.00