

Registration Statement

OF CLAIMANT OF RIGHT TO APPROPRIATE GROUND WATER

TO THE STATE ENGINEER OF OREGON:

I, Mrs. Mary Blacklaw

of 244 Poplar St., Walla Walla County of Walla Walla

(Mailing address)

State of Washington, do hereby make application for a certificate of registration as evidence of a right to appropriate ground water.

1. Source from which water is withdrawn is Pump Well No. 1 (Flowing well, pump well, infiltration trench, or tunnel)

2. Location is: 4 miles northeast of Lebanon, Oregon (Approximate distance and direction from nearest city or town)

and is more particularly described as follows:

(a) 50.40' E. 29.5 chains from NE cor. DIC 57, T. 11 S. R. 2 E. W. 4 (Give distance and bearing to corner of section or other legal subdivision)

being within NE 1/4 of SE 1/4 of Sec. 26, Twp. 11 S., Rge. 2 E. (Smallest legal subdivision) (N. or S.) (E. or W.)

or (b) within limits of recorded platted property, town or city;

in Lot _____ Block _____ of _____ (Name of plat or addition)

County of Inn (If within city or town, give name)

3. Construction Work was begun on Aug. 1952; was completed on Aug. 1952 (Date) (Date)

and the ground water claimed was first used for the purposes set out below on June 1953 (Date)

since which time the water has been used continuously (Continuously or intermittently)

from June 1953 to present time (Date) (Date)

4. Quantity of water claimed and used is 720 gallons per minute; 186.75 acre feet per year.

5. Purpose or Purposes for which water is used Irrigation (Domestic, irrigation, municipal, manufacturing, industrial, etc.)

6. Description of Well: Depth 25 feet. Type Drilled (Dug or drilled)

diameter 10 inches. Elevation of ground at well site 310 feet, mean sea level. (As near as known)

Depth to water table 15 feet.

7. Capacity of Well: 1000 g.p.m. with 4 feet drawdown.

_____ g.p.m. with _____ feet drawdown.

Date of test June 1953

If Flowing Well: Measured discharge _____ g.p.m. on _____ (Date)

Shut-in pressure at ground surface _____ lbs. per sq. in. on _____ (Date)

Water is controlled by _____ (Cap, valve, etc.)

8. Casing: (Give diameter, commercial specifications and depth below ground surface of each casing size.)

10 inch diameter steel casing from 0 to 25 feet
 inch diameter from to feet
 inch diameter from to feet
 inch diameter from to feet

Describe and show depth of shoe, plug, adapter, liner or other details:

9. Perforated Casings or Screens:

Slot perforations from 19 to 25
(Number per foot and size of perforations, or describe screen)
 from to
 from to
 from to

10. Log of Well: (Describe each stratum or formation clearly, indicate if water bearing, and give thickness and depth as indicated.)

MATERIAL	Thickness (Feet)	Depth to Bottom (Feet)
Not available		

If log of well is not available, give name and address of driller: Bill Hamilton Drilling Co.,
838 East Third Avenue, Albany, Oregon

11. Infiltration Trench: Covered or open
 Dimensions: Length ft. Minimum depth ft. Maximum depth ft.
 Bottom width ft. Discharge g.p.m. Date of test

12. Tunnel: Type of lining
 Dimensions:
 (Length, course, and cross sectional size)
 Position of water bearing stratum with reference to portal of tunnel

Log of tunnel: (Preceding table for log of well may be used, if desired. Give footage from portal and character of materials, as pertinent.)

13. Pumping Equipment:
 (a) Pump Jacuzzi Turbine Capacity 750 g.p.m.
 (Make, type and size)
 (b) Motor 25 H. P. electric
 (Type and horsepower)

14. Location of area irrigated or to be irrigated, or place of use if for purposes other than irrigation.


Township North or South	Range E. or W. of Willamette Meridian	Section	Forty-acre Tract	Number Acres To Be Irrigated	Date of Reclamation
11 S	2 W	25	SW $\frac{1}{4}$ of SW $\frac{1}{4}$	1.7	June 1953
11 S	2 W	25	NW $\frac{1}{4}$ of SW $\frac{1}{4}$	38.5	June 1953
11 S	2 W	25	SW $\frac{1}{4}$ of SW $\frac{1}{4}$	3.6	" "
11 S	2 W	25	SE $\frac{1}{4}$ of SW $\frac{1}{4}$	1.3	" "
11 S	2 W	25	NE $\frac{1}{4}$ of SW $\frac{1}{4}$	7.2	" "
11 S	2 W	26	SE $\frac{1}{4}$ of NE $\frac{1}{4}$	2.6	" "
11 S	2 W	26	NE $\frac{1}{4}$ of SE $\frac{1}{4}$	14.2	" "
11 S	2 W	26	SE $\frac{1}{4}$ of SE $\frac{1}{4}$	1.6	" "

beginning 13.55 chains south of the northern corner of the ...
 and wide, ... 11 1/2 chains ...
 Oregon; and running thence east 32 chains to the ...
 thence S. 89° ... a point 11.35 chains south ...
 thence east to the west corner of the ...

tract: beginning 27.10 chains south of the ...
 corner, ... 11 1/2 ... of the ...
 thence east 27.10 chains; thence south 11.35 chains; thence ...
 north 11.35 chains to the place of beginning.

15. If the ground water supply is supplemental to an existing water supply, identification of any application for a permit, certificate or adjudicated right to appropriate water made or held by the registrant.

Township 11 S Range 2 W, W.M.
North

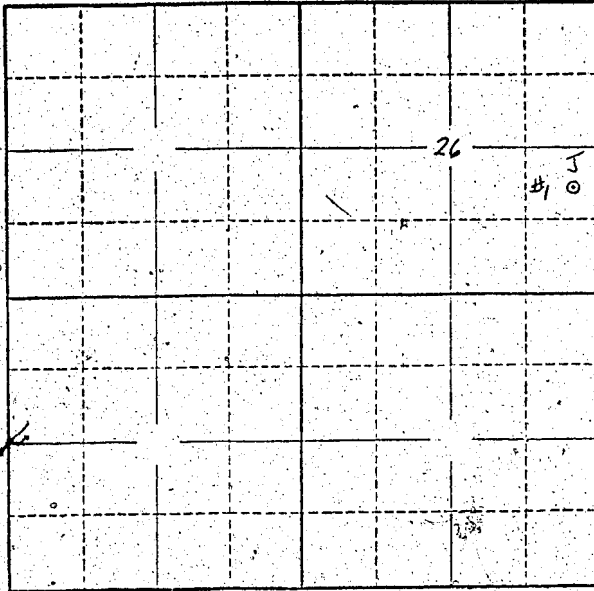

Locate well and acreage of irrigated land on plat.
Scale: 2" = 1 Mile

WASHINGTON
STATE OF OREGON

County of Walla Walla

} ss.

I, Mrs. Mary Blacklaw, being first duly sworn, do hereby certify that I have read the foregoing Registration Statement and that all of the items therein contained are true to the best of my knowledge and belief.

Mrs. Mary Blacklaw
(Signature of Registrant)

Subscribed and sworn to before me this 21 day of July, 1958

My commission expires 12-12-60

John E. ...
(Notary Public)

(SEAL)

CERTIFICATE OF REGISTRATION

STATE OF OREGON

County of Marion

} ss.

This is to certify that the foregoing Registration Statement was received in the office of the State Engineer on the 30 day of July, 1958, at ... o'clock ... M. and has been duly recorded in said office in Book No. 13 of Registration Statements on page GR-3165

Witness my hand this 18th day of June, 1959

Lewis A. Stanley
(State Engineer)

By ...
(Deputy)

21-75