REGISTRATION NO. GR-342

CERTIFICATE NO. GR-327

JAN 1 1957
STATE ENGINEER
SALEM, OREGON

Registration Statement

OF CLAIMANT OF RIGHT TO APPROPRIATE GROUND WATER

(Under Chapter 708, Oregon Laws 1955.)

TO THE STATE ENGINEER OF OREGON:

I, Ovid G. Long Box 302,

of Independence, Oregon County of Polk

State of Oregon, do hereby make application for a certificate of registration as evidence of a right to appropriate ground water.

1. **Source** from which water is withdrawn is Pump Well (Flowing well, pump well, infiltration trench, or tunnel)

2. **Location is:** 5½ miles S.E. of Independence, Oreg (Approximate distance and direction from nearest city or town);

and is more particularly described as follows:

(a) 11.02 chains East and 26 chains south from of the Northeast corner of Claim NO 57 T-9 S R-4 west of the Willamette Meridian, (Give distance and bearing to corner of section or other legal subdivision)

being within NW¼ of the SE¼ (Smallest legal subdivision) of Sec. 11, Twp. 9 S (N. or S.), Rge. 4 W (E. or W.)

or (b) within limits of recorded platted property, town or city:

in Lot ....., Block ..... of ..... (Name of plat or addition)

..... (If within city or town, give name) County of .....

3. **Construction Work** was begun on Mar-1948 (Date); was completed on Mar-1948 (Date)

and the ground water claimed was first used for the purposes set out below on Season -1948 (Date),

since which time the water has been used Continually (Continuously or intermittently)

from Seasonl needs (Date) (Date)

4. **Quantity** of water claimed and used is 550 gallons per minute; ..... acre feet per year.

5. **Purpose or Purposes** for which water is used Irrigation

..... (Domestic, irrigation, municipal, manufacturing, industrial, etc.)

6. **Description of Well:** Depth 33 feet. Type Drilled (Dug or drilled)

diameter 12 inches. Elevation of ground at well site ~~unknown~~ 165 (As near as known) feet, mean sea level.

Depth to water table 14 feet.

7. **Capacity of Well:** Apr 620 g.p.m. with unknown feet drawdown.

..... g.p.m. with ..... feet drawdown.

Date of test Mar-1948

If Flowing Well: Measured discharge ..... g.p.m. on ..... (Date)

Shut-in pressure at ground surface ..... lbs. per sq. in. on ..... (Date)

Water is controlled by ..... (Cap, valve, etc.)

8. **Casing:** (Give diameter, commercial specifications and depth below ground surface of each casing size.)

12 inch diameter unknown from ..... to ..... feet

..... inch diameter ..... from ..... to ..... feet

..... inch diameter ..... from ..... to ..... feet

..... inch diameter ..... from ..... to ..... feet

Describe and show depth of shoe, plug, adapter, liner or other details: .....

9. **Perforated Casings or Screens:**

Perforated (other unknown) from ..... to .....
(Number per foot and size of perforations, or describe screen)

..... from ..... to .....

..... from ..... to .....

..... from ..... to .....

10. **Log of Well:** (Describe each stratum or formation clearly, indicate if water bearing, and give thickness and depth as indicated.)

MATERIAL	Thickness (Feet)	Depth to Bottom (Feet)
unknown		

GR-327 A

If log of well is not available, give name and address of driller. .....

E. Hamilton, Albany, Oregon

11. **Infiltration Trench:** Covered or open .....

Dimensions: Length ..... ft. Minimum depth ..... ft. Maximum depth ..... ft.

Bottom width ..... ft. Discharge ..... g.p.m. Date of test .....

12. **Tunnel:** Type of lining .....

Dimensions: ..... (Length, course, and cross sectional size)

Position of water bearing stratum with reference to portal of tunnel .....

Log of tunnel: (Preceding table for log of well may be used, if desired. Give footage from portal and character of materials, as pertinent.)

13. **Pumping Equipment:**

(a) Pump FM 4X3 (Make, type and size) Capacity 500 g.p.m.

(b) Motor 25hp -FM (Type and horsepower)

14. Location of area irrigated or to be irrigated, or place of use if for purposes other than irrigation.

Township North or South	Range E. or W. of Willamette Meridian	Section	Forty-acre Tract	Number Acres To Be Irrigated	Date of Reclamation
9 S	4 west	11		48	1948
"	"	"	SW 1/4 of the NE 1/4	18	"
"	"	"	NW 1/4 of the SE 1/4	22	"
"	"	"	SW 1/4 of the SE 1/4	8	"
				48, total	

15. If the ground water supply is supplemental to an existing water supply, identification of any application for a permit, permit, certificate or adjudicated right to appropriate water made or held by the registrant.

.....

GR-327B

Township 9 S Range ~~13~~ 4W, W.M. west

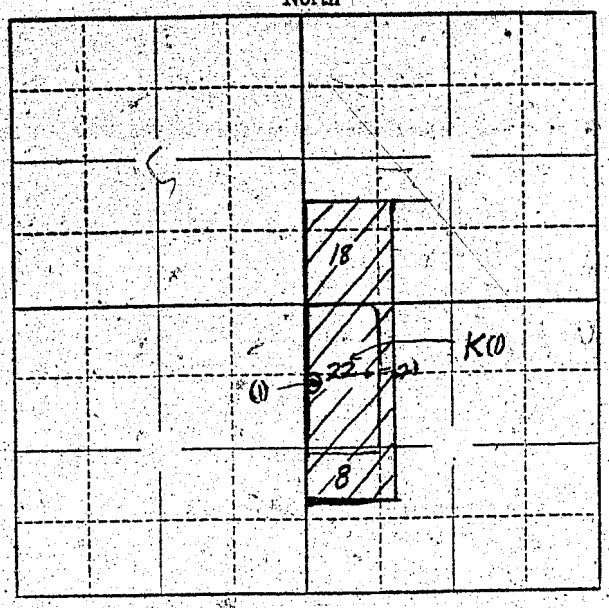

Locate well and acreage of irrigated land on plat.

Scale: 2" — 1 Mile

STATE OF OREGON
County of ..... } ss.

I, ..., being first duly sworn, do hereby certify that I have read the foregoing Registration Statement and that all of the items therein contained are true to the best of my knowledge and belief.

Ovid G. Long
(Signature of Registrant)
Ovid G. Long

Subscribed and sworn to before me this 11th day of January, 1957

My commission expires NOTARY PUBLIC FOR OREGON
My Commission Expires Jan. 27, 1959
(Notary Public)

(SEAL)

CERTIFICATE OF REGISTRATION

STATE OF OREGON
County of Marion } ss.

This is to certify that the foregoing Registration Statement was received in the office of the State Engineer on the 21st day of January, 19 57, at 10:00 o'clock A. M. and has been duly recorded in said office in Book No. 2 of Registration Statements on page GR-327 C

~~Construction shall be completed by x-x-x-x-x-x-x-x-x-x-19x-x-x and the water completely applied to beneficial use by x-x-x-x-x-x-x-x-x-x-19-x-x-~~

Witness my hand this 1st day of April, 19 57

Lewis A. Stanley
(State Engineer)

By .....
(Deputy)

#1720

GR-327C