

Registration Statement

OF CLAIMANT OF RIGHT TO APPROPRIATE GROUND WATER

TO THE STATE ENGINEER OF OREGON:

I, Klase Wollander & wa
of Rt 1 Box 33 Jefferson County of Marion
(Mailing address)

State of Oregon, do hereby make application for a certificate of registration as evidence of a right to appropriate ground water.

1. Source from which water is withdrawn is Flowing well
(Flowing well, pump well, infiltration trench, or tunnel)

2. Location is: _____
(Approximate distance and direction from nearest city or town)

and is more particularly described as follows:

(a) about 1160 feet west and 200 feet north from the SE corner Section 10
(Give distance and bearing to corner of section or other legal subdivision)

being within SE 1/4 of the SE 1/4 of Sec. 10, Twp. 9S, Rge. 3 W
(Smallest legal subdivision) (or S.) (or W.)

or (b) within limits of recorded platted property, town or city: _____

in Lot _____, Block _____ of _____
(Name of plat or addition)

_____ County of _____
(If within city or town, give name)

3. Construction Work was begun on Aug 1, 1952; was completed on Aug 3, 1952
(Date) (Date)

and the ground water claimed was first used for the purposes set out below on Aug 3, 1952
(Date)

since which time the water has been used Continuously throughout season
(Continuously or [intermittently])

from Aug 3 to July 31, 1958
(Date) (Date)

4. Quantity of water claimed and used is 60 gallons per minute; _____ acre feet per year.

5. Purpose or Purposes for which water is used irrigation
(Domestic, irrigation, municipal, manufacturing, industrial, etc.)

6. Description of Well: Depth 20 feet. Type hand dug
(Dug or drilled)

diameter 6 inches. Elevation of ground at well site 70 feet feet, mean sea level.
(As near as known)

Depth to water table flowing feet.

7. Capacity of Well: 60 g.p.m. with 40 feet drawdown.
_____ g.p.m. with _____ feet drawdown.


Date of test Aug 3, 1952

If Flowing Well: Measured discharge 15 g.p.m. on Aug 3, 1952
(Date)

Shut-in pressure at ground surface _____ lbs. per sq. in. on _____
(Date)

Water is controlled by valves
(Cap, valve, etc.)

Township 9s Range 3W, W.M.
North

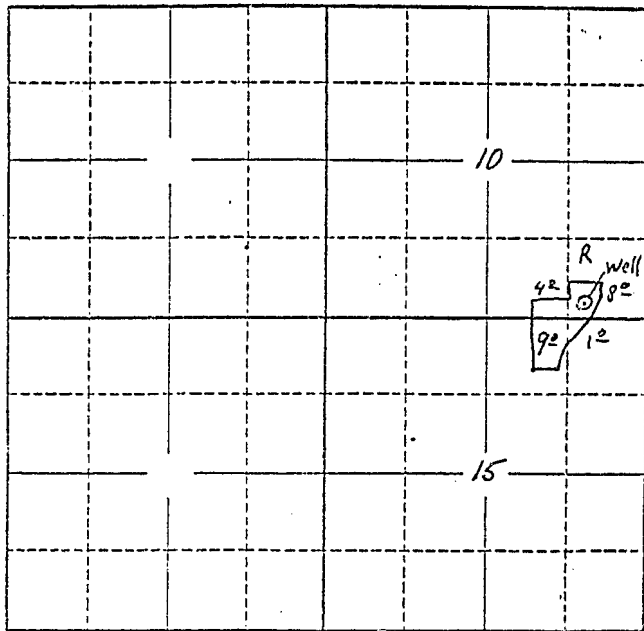

Locate well and acreage of irrigated land on plat.
Scale: 2" = 1 Mile

STATE OF OREGON

County of _____ } ss.

I, Harold Hollander, being first duly sworn, do hereby certify that I have read the foregoing Registration Statement and that all of the items therein contained are true to the best of my knowledge and belief.

Harold Hollander
(Signature of Registrant)

Subscribed and sworn to before me this 10th day of June, 1966.

My commission expires Nov 3, 1969

Samuel M. [Signature]
(Notary Public)

(SEAL)

CERTIFICATE OF REGISTRATION

This statement filed in lieu of original statement lost.

STATE OF OREGON

County of Marion } ss.

This is to certify that the foregoing Registration Statement was received in the office of the State Engineer on the 10th day of June, 1966, at 1:50 o'clock P.M. and has been duly recorded in said office in Book No. 17 of Registration Statements on page GR-4155

Witness my hand this 5th day of August, 1966.

[Signature]
(State Engineer)

By _____
(Deputy)

\$15.00