

Registration Statement

OF CLAIMANT OF RIGHT TO APPROPRIATE GROUND WATER

TO THE STATE ENGINEER OF OREGON:

I, ^{AND} J. M. OR. JOSEPHINE BENNETT

of P.O. Box 187 SHERWOOD County of WASHINGTON

State of OREGON do hereby make application for a certificate of registration as evidence of a right to appropriate ground water.

1. Source from which water is withdrawn is PUMP WELL
(Flowing well, pump well, infiltration trench, or tunnel)

2. Location is: 1 1/2 MILES WEST OF TUALATIN
(Approximate distance and direction from nearest city or town)

and is more particularly described as follows:
From W 1/2 Corner 1760.32' thence South 647.8' to well
(a) 1220.22' N. 89° 48' E. ON CENTER LINE OF SEC. 22-T2-R.1W. TO CORNER OF LOT 3.
(Give distance and bearing to corner of section or other legal subdivision)

being within NE 1/4 OF S. 1/4 of Sec. 22, Twp. 2. S., Rge. 1. W.
(Smallest legal subdivision) (N. or S.) (E. or W.)

or (b) within limits of recorded platted property, town or city:

in Lot 3, Block of EDDY ALPES
(Name of plat or addition)

County of WASHINGTON
(If within city or town, give name)

3. Construction Work was begun on SEPT 13, 1951; was completed on OCT. 10, 1951
(Date) (Date)

and the ground water claimed was first used for the purposes set out below on MAY 1953
(Date)

since which time the water has been used INTERMITTENTLY
(Continuously or intermittently)

from MAY 1953 to JULY 1958
(Date) (Date)

4. Quantity of water claimed and used is 14 1/2 gallons per minute; _____ acre feet per year.

5. Purpose or Purposes for which water is used IRRIGATION.

(Domestic, irrigation, municipal, manufacturing, industrial, etc.)

6. Description of Well: Depth 9' 9" feet. Type DUG
(Dug or drilled)

diameter 37 inches. Elevation of ground at well site APPROX 133 feet, mean sea level.
(As near as known)

Depth to water table 5' 4" feet.

Capacity of Well: 75 g.p.m. with little feet drawdown.

_____ g.p.m. with 9" feet drawdown.


Date of test, July 8, 1958

If Flowing Well: Measured discharge _____ g.p.m. on _____
(Date)

Shut-in pressure at ground surface _____ lbs. per sq. in. on _____
(Date)

Water is controlled by _____
(Cap, valve, etc.)

Township 2-S, Range 1-W, W.M. North

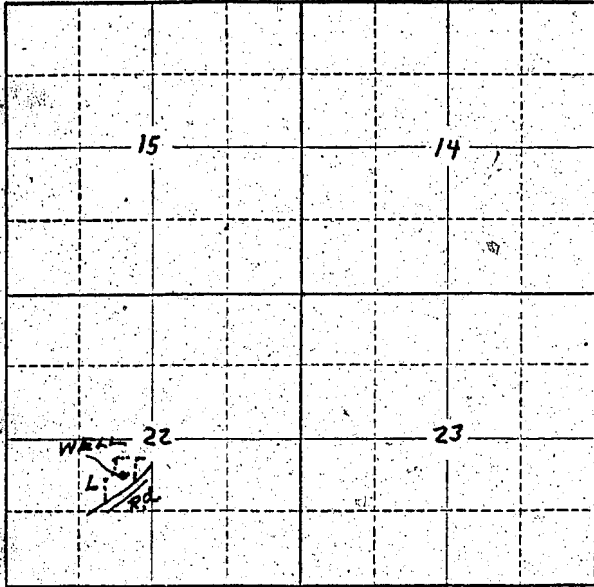

Locate well and acreage of irrigated land on plat.

Scale: 2" = 1 Mile

STATE OF OREGON

County of Marion

ss.

I, _____, being first duly sworn, do hereby certify that I have read the foregoing Registration Statement and that all of the items therein contained are true to the best of my Knowledge and belief.

R.M. Bennett
Josephine Bennett
(Signature of Registrant)

Subscribed and sworn to before me this 31st day of July, 1958.

My commission expires 12th June 1961.

Wm. S. Bartholomew
(Notary Public)

(SEAL)

CERTIFICATE OF REGISTRATION

STATE OF OREGON

County of Marion

ss.

This is to certify that the foregoing Registration Statement was received in the office of the State Engineer on the 31 day of July, 1958, at 2:00 o'clock P. M. and has been duly recorded in said office in Book No. 13 of Registration Statements on page GR-3167

Witness my hand this 18th day of June, 1959.

Lewis A. Stanley
(State Engineer)

By _____

(Deputy)

GR-3167

\$15.00