

Registration Statement

REG. NO. 6R-3425
CERTIFICATE NO. GR-3169

OF CLAIMANT OF RIGHT TO APPROPRIATE GROUND WATER

(Under Chapter 708, Oregon Laws 1955.)

TO THE STATE ENGINEER OF OREGON:

I, L. M. BANISTER

of CORNELIUS County of WASHINGTON

State of OREGON, do hereby make application for a certificate of registration as evidence of a right to appropriate ground water.

1. Source from which water is withdrawn is PUMP WELL #A
(Flowing well, pump well, infiltration trench, or tunnel)

2. Location is: 3 MILES NORTH OF CORNELIUS
(Approximate distance and direction from nearest city or town)

and is more particularly described as follows:

(a) WELL-A - 360° ft. N.E. of 825' ft. West
OF 1/4 COR ON E. LINE SEC 21
(Give distance and bearing to corner of section or other legal subdivision)

being within S.E. 1/4 OF N.E. 1/4 of Sec. 21, Twp. 1N, Rge. 3W
(Smallest legal subdivision) (N. or S.) (E. or W.)

or (b) within limits of recorded platted property, town or city:

in Lot _____, Block _____ of _____
(Name of plat or addition)

County of _____
(If within city or town, give name)

3. Construction Work was begun on MARCH 1954; was completed on APRIL - 1954
(Date) (Date)

and the ground water claimed was first used for the purposes set out below on MAY - 1954
(Date)

since which time the water has been used INTERMITTENTLY
(Continuously or intermittently)

from MAY 1954 to JULY - 1958
(Date) (Date)

4. Quantity of water claimed and used is 25 gallons per minute; .7813 acre feet per year.

5. Purpose or Purposes for which water is used IRRIGATION

(Domestic, irrigation, municipal, manufacturing, industrial, etc.)

6. Description of Well: Depth 80 feet. Type DRILLED
(Dug or drilled)

diameter 8 inches. Elevation of ground at well site 190 feet, mean sea level.
(As near as known)

Depth to water table 12 feet.

7. Capacity of Well: 25 g.p.m. with 18 feet drawdown.

 g.p.m. with feet drawdown.

Date of test _____

If Flowing Well: Measured discharge _____ g.p.m. on _____

(Date)

Shut-in pressure at ground surface _____ lbs. per sq. in. on _____

(Date)

Water is controlled by _____

6 (Cap, valve, etc.)

8. Casing: (Give diameter, commercial specifications and depth below ground surface of each casing size.)

..... inch diameter from to feet
 inch diameter from to feet
 inch diameter from to feet
 inch diameter from to feet

Describe and show depth of shoe, plug, adapter, liner or other details:

.....

9. Perforated Casings or Screens:

..... from to
(Number per foot and size of perforations, or describe screen)
 from to
 from to
 from to

10. Log of Well: (Describe each stratum or formation clearly, indicate if water bearing, and give thickness and depth as indicated.)

MATERIAL	Thickness (Feet)	Depth to Bottom (Feet)
NO KNOWLEDGE OF ANY LOGGING MADE		

If log of well is not available, give name and address of driller. JAMES BRITTEN, FORMER OWNER

ADDRESS UNKNOWN

11. Infiltration Trench: Covered or open
 Dimensions: Length ft. Minimum depth ft. Maximum depth ft.
 Bottom width ft. Discharge g.p.m. Date of test

12. Tunnel: Type of lining
 Dimensions:
(Length, course, and cross sectional size)
 Position of water bearing stratum with reference to portal of tunnel

Log of tunnel: (Preceding table for log of well may be used, if desired. Give footage from portal and character of materials, as pertinent.)


13. Pumping Equipment:
 A - CO-OP - JET
 A - ~~JACAZAL JET~~
 A - JET - 1 1/2 HP
 B - ~~JET 1 HP~~
 (a) Pump Capacity 25 g.p.m.
(Make, type and size)
 (b) Motor
(Type and horsepower)

14. Location of area irrigated or to be irrigated, or place of use if for purposes other than irrigation.

Township North or South	Range E. or W. of Willamette Meridian	Section	Forty-acre Tract	Number Acres To Be Irrigated	Date of Reclamation
T1N	R3W	21	SE 1/4 of NE 1/4	10 ⁰	1954

15. If the ground water supply is supplemental to an existing water supply, identification of any application for a permit, permit, certificate or adjudicated right to appropriate water made or held by the registrant.

Township 1 N Range 3 W W.M. North

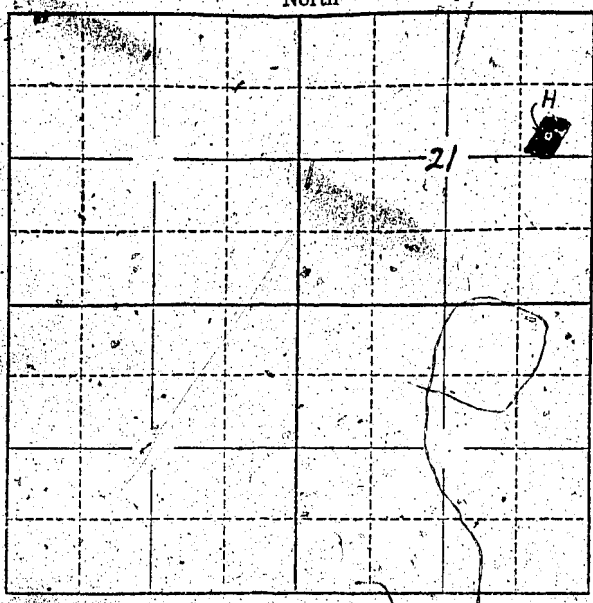

Locate well and acreage of irrigated land on plat.
Scale: 2" = 1 Mile

STATE OF OREGON

County of Washington } ss.

I, H. M. Barnette being first duly sworn, do hereby certify that I have read the foregoing Registration Statement and that all of the items therein contained are true to the best of my knowledge and belief.

H. M. Barnette
(Signature of Registrant)

Subscribed and sworn to before me this 14 day of July, 1958

My commission expires Dec 4, 1959

J. B. Hamilton
(Notary Public)

(SEAL)

CERTIFICATE OF REGISTRATION

STATE OF OREGON

County of Marion } ss.

This is to certify that the foregoing Registration Statement was received in the office of the State Engineer on the 15th day of July, 1958, at 2.00 o'clock A. M. and has been duly recorded in said office in Book No. 13 of Registration Statements on page GR 3169

~~* Construction shall be completed by 10 and the water completely applied for beneficial use by 19~~

Witness my hand this 18th day of June, 1959

Lewis A. Stanlin
(State Engineer)

\$15.00

By GR-3169
(Deputy)