

RECEIVED
DEC 28 1956
STATE ENGINEER
SALEM, OREGON

Registration Statement

REG. NO. GR-343
CERTIFICATE NO. GR-328

OF CLAIMANT OF RIGHT TO APPROPRIATE GROUND WATER

(Under Chapter 708, Oregon Laws 1955.)

WELL #1

TO THE STATE ENGINEER OF OREGON:

I, ROBERT O. MALSEY

of CITY OF BEAVERTON County of WASHINGTON

State of OREGON, do hereby make application for a certificate of registration as evidence of a right to appropriate ground water.

1. Source from which water is withdrawn is PUMP WELL #1
(Flowing well, pump well, infiltration trench, or tunnel)

2. Location is: 1.5 MILE NORTHEAST OF BEAVERTON
(Approximate distance and direction from nearest city or town)

and is more particularly described as follows:

(a) 2550 feet east and 220 feet south from West 1/4 corner of section 11
See enclosed description
(Give distance and bearing to corner of section or other legal subdivision)

being within NE 1/4 of SW 1/4 of Sec. 11, Twp. 15, Rge. 1W
(Smallest legal subdivision) (N. or S.) (E. or W.)

or (b) within limits of recorded platted property, town or city:

in Lot _____, Block _____ of _____
(Name of plat or addition)

County of _____

(If within city or town, give name)

3. Construction Work was begun on 1932; was completed on 1932
(Date) (Date)

and the ground water claimed was first used for the purposes set out below on 1933
(Date)

since which time the water has been used intermittently
(Continuously or Intermittently)

from 1933 to PRESENT
(Date) (Date)

4. Quantity of water claimed and used is 400 gallons per minute; _____ acre feet per year.

5. Purpose or Purposes for which water is used MUNICIPAL

(Domestic, irrigation, municipal, manufacturing, industrial, etc.)

6. Description of Well: Depth 825 feet. Type DRILLED
(Dug or drilled)

diameter 10 inches. Elevation of ground at well site 360 ± feet, mean sea level.
(As near as known)

Depth to water table 180 feet.

7. Capacity of Well: UNKNOWN g.p.m. with 40 feet drawdown.

_____ g.p.m. with _____ feet drawdown.

Date of test 1932

If Flowing Well: Measured discharge _____ g.p.m. on _____
(Date)

Shut-in pressure at ground surface _____ lbs. per sq. in. on _____
(Date)


Water is controlled by _____
(Cap, valve, etc.)

8. Casing: (Give diameter, commercial specifications and depth below ground surface of each casing size.)

10 inch diameter from 0 to 215.4 feet
 8 inch diameter from 215.4 to 609.9 feet
 UNCASED inch diameter from to feet
 inch diameter from to feet

Describe and show depth of shoe, plug, adapter, liner or other details:
 APPROXIMATELY 3" OFFSET IN CASING AT 215.4 FT level

9. Perforated Casings or Screens:

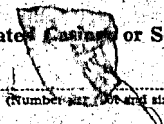

NONE

(Number, size, type and size of perforations, or describe screen)

from to
 from to
 from to
 from to

10. Log of Well: (Describe each stratum or formation clearly, indicate if water bearing, and give thickness and depth as indicated.)

MATERIAL	Thickness (Feet)	Depth to Bottom (Feet)
BORING LAVA (BASALT):		
ROCK, RED & GRAY (CREVICE AT 59')	59	59
ROCK, RED (CREVICE AT 88')	52	111
TROUTDALE FORMATION:		
CLAY, YELLOW, BLUE and RED	492	553
SANDSTONE, YELLOW	10	563
COLUMBIA RIVER BASALT:		
ROCK, WITH CLAY	89	650
ROCK, HARD	10	660
ROCK, LAVA	38	698
ROCK, BLACK	10	708
ROCK, BLACK, VERY HARD	27	735

If log of well is not available, give name and address of driller.

11. Infiltration Trench: Covered or open

Dimensions: Length _____ ft. Minimum depth _____ ft. Maximum depth _____ ft.

Bottom width _____ ft. Discharge _____ g.p.m. Date of test _____

12. Tunnel: Type of lining

Dimensions: _____
(Length, course, and cross sectional size)

Position of water bearing stratum with reference to portal of tunnel

Log of tunnel: (Preceding table for log of well may be used, if desired. Give footage from portal and character of materials, as pertinent.)

13. Pumping Equipment:

(a) Pump PAMONA DEEP WELL TURBINE Capacity 500 g.p.m.
(Make, type and size)

(b) Motor GEN. ELECTRIC 40 HP
(Type and horsepower)

14. Location of area irrigated or to be irrigated, or place of use if for purposes other than irrigation.

Township North or South	Range E. or W. of Willamette Meridian	Section	Forty-acre Tract	Number Acres To Be Irrigated	Date of Reclamation
<u>CORPORATE AND FRINGE AREA - BEAVERTON, OREGON</u>					
<u>RADIUS - APPROXIMATELY 2 MILES FROM CITY CENTER</u>					
<u>PORTIONS OF SECTIONS 14, 15, 16, 21 AND 22 T. 15. R. 1W. W.M.</u>					
			<u>N$\frac{1}{4}$ W$\frac{1}{2}$ E$\frac{1}{2}$ NE$\frac{1}{4}$</u>	<u>NW$\frac{1}{4}$</u>	


OREGON INVESTMENT & MORTGAGE COMPANY TO TOWN OF BEAVERTON

KNOW ALL MEN BY THESE PRESENTS, That Oregon Investment & Mortgage Company, a corporation duly organized and incorporated under the laws of the State of Oregon, in consideration of ten no/100 (10.00) Dollars, to it paid by the Town of Beaverton Washington County, Oregon, does hereby grant, bargain, sell and convey to said Town of Beaverton its assigns forever, the following described parcel of real estate, situate, lying and being in the County of Washington and State of Oregon to-wit: Commencing at a point forty (40) chains north of the quarter section corner between sections eleven (11) and fourteen (14), township one (1) south, range one (1), W. of W. M.; thence west one hundred and twenty-five (125) feet; thence south two hundred and twenty-five (225) feet; thence east one hundred and twenty-five (125) feet to the quarter-section line of section eleven (11); thence north two hundred and twenty-five (225) feet to the place of beginning, being a tract of land 125 x 225 feet in size, at the northeast corner of land described in deed recorded in Book 116, page 86 of the Deed Records of Washington County, Oregon.

15. If the ground water supply is supplemental to an existing water supply, identification of any application for a permit, permit, certificate or adjudicated right to appropriate water made or held by the registrant.

SECTION 11

Township 15 Range 14 W.M.
North

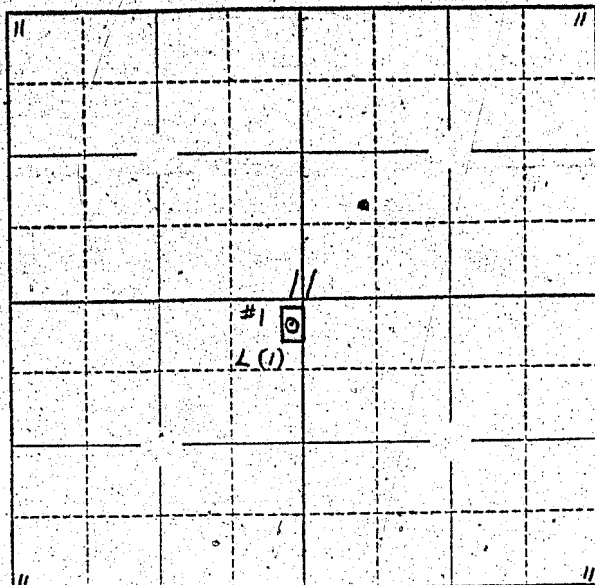

Locate well and acreage of irrigated land on plat.
Scale: 2" = 1 Mile

STATE OF OREGON

County of

} ss.

I, being first duly sworn, do hereby certify that I have read the foregoing Registration Statement and that all of the items therein contained are true to the best of my knowledge and belief.

.....
(Signature of Registrant)

Subscribed and sworn to before me this day of, 19.....

My commission expires

.....
(Notary Public)

(SEAL)

See Page GR-328 G
CERTIFICATE OF REGISTRATION

STATE OF OREGON

County of Marion

} ss.

~~This is to certify that the foregoing Registration Statement was received in the office of the State Engineer on the ~~xx-xx-xx~~ day of ~~xx-xx-xx~~, 19~~xx~~, and has been duly recorded in said office in Book No. ~~xx-xx-xx~~ of Registration Statements on page ~~xx-xx-xx~~.~~

~~Construction shall be completed by ~~xx-xx-xx~~, 19~~xx~~, and the water completely applied to beneficial use by ~~xx-xx-xx~~, 19~~xx~~.~~

~~Witness my hand this ~~xx-xx~~ day of ~~xx-xx~~, 19~~xx~~.~~

.....
(State Engineer)

By

.....
(Deputy)

GR-328 C

RECEIVED
DEC 23 1956
STATE ENGINEER
ELEM. OREGON

OF CLAIMANT OF RIGHT TO APPROPRIATE GROUND WATER

(Under Chapter 703, Oregon Laws 1955.)

WELL #2

TO THE STATE ENGINEER OF OREGON:

I, ROBERT O. MALSEY
of CITY OF BEAVERTON County of WASHINGTON
State of OREGON, do hereby make application for a certificate of registration as evidence
of a right to appropriate ground water.

1. Source from which water is withdrawn is PUMP WELL #2
(Flowing well, pump well, infiltration trench, or tunnel)

2. Location is: 1.5 MILES SOUTHWEST OF BEAVERTON
(Approximate distance and direction from nearest city or town)

and is more particularly described as follows:
(a) 2500 feet east and 460 feet north from the SW corner of section 21.
See enclosed description
(Give distance and bearing to corner of section or other legal subdivision)

being within SE 1/4 of SW 1/4 of Sec. 21, Twp. 1 S, Rge. 1 W
(Smallest legal subdivision) (Twp. or S.) (R. or W.)

or (b) within limits of recorded platted property, town or city:

in Lot _____, Block _____ of _____
(Name of plat or addition)

County of _____
(If within city or town, give name)

3. Construction Work was begun on 1945; was completed on 1945
(Date) (Date)

and the ground water claimed was first used for the purposes set out below on 1946
(Date)

since which time the water has been used intermittently
(Continuously or intermittently)

from 1946 to PRESENT
(Date) (Date)

4. Quantity of water claimed and used is 950 gallons per minute; _____ acre
feet per year.

5. Purpose or Purposes for which water is used _____

MUNICIPAL
(Domestic, irrigation, municipal, manufacturing, industrial, etc.)

6. Description of Well: Depth 800 feet. Type DRILLED
(Dug or drilled)

diameter 16 inches. Elevation of ground at well site 350 ± feet, mean sea level.
(As near as known)

Depth to water table 170 feet.

7. Capacity of Well: UNKNOWN g.p.m. with 80 ± feet drawdown.

_____ g.p.m. with _____ feet drawdown.

Date of test DEC. 1945

If Flowing Well: Measured discharge _____ g.p.m. on _____
(Date)

Shut-in pressure at ground surface _____ lbs. per sq. in. on _____
(Date)

Water is controlled by _____
(Cap, valve, etc.)

If log of well is not available, give name and address of driller.

11. Infiltration Trench: Covered or open

Dimensions: Length ft. Minimum depth ft. Maximum depth ft.

Bottom width ft. Discharge g.p.m. Date of test

12. Tunnel: Type of lining

Dimensions:
(Length, course, and cross sectional size)

Position of water bearing stratum with reference to portal of tunnel

Log of tunnel: (Preceding table for log of well may be used, if desired. Give footage from portal and character of materials, as pertinent.)

13. Pumping Equipment:

(a) Pump FAIRBANKS - MORSE - RAMONA TURBINE Capacity 950 g.p.m.
(Make, type and size)

(b) Motor FAIRBANKS - MORSE 60 H.P.
(Type and horsepower)

14. Location of area irrigated or to be irrigated, or place of use if for purposes other than irrigation.

Township North or South	Range E. or W. of Willamette Meridian	Section	Forty-acre Tract	Number Acres To Be Irrigated	Date of Reclamation
<u>CORPORATE AND FRINGE AREA - BEAVERTON, OREGON</u>					
<u>RADIUS SERVED - APPROXIMATELY 2 MILES FROM CITY CENTER</u>					
<u>PORTIONS OF SECTIONS ^{NW/4} 14, ^{W/2} 15, ^{E/2} 16, ^{NE/4} 21 AND ^{NW/4} 22 T1S R1W U.M.</u>					

Hargis which is described on Page 161, Volume 226, Deed Records of Washington County, Oregon, said point being 552.8 feet North of the 1/4 corner on the South line of Section 21, T1S, R1W of the Willamette Meridian and 5 feet North of the Northwest corner of a tract of land now owned by Guy O. Woodworth, which is described on Page 399, Volume 238, Deed Records of Washington County, Oregon; thence Westerly parallel to the South line of said Section 21, a distance of 200 feet to a point; thence Southerly parallel to the East line of the said Hargis tract a distance of 305 feet to a point; thence Easterly parallel to the South line of said Section 21, a distance of 200 feet to a point on the East line of said Hargis tract, said point being 247.8 feet North of the 1/4 corner, on the South line of said Section 21; thence Northerly along the East line of the said Hargis tract a distance of 305 feet to the place of beginning, 1.4 acres, more or less.


ALSO

Beginning at a point on the East line of a tract of land conveyed to William I. Hargis, et ux, by deed recorded in Book 226, page 161, Deed Records of Washington County, Oregon; 247.8 feet North of the quarter section corner on the South line of Section 21, in Township 1 South Range 1 West of the Willamette Meridian, in Washington County, Oregon; thence westerly 200 feet to the point of beginning, said point being the southwest corner of land now owned by the City of Beaverton; thence westward 25 feet, along an extension of the South boundary of property owned by City of Beaverton; thence northerly and parallel to the West boundary of City of Beaverton's property a distance of 275 feet; thence westerly and parallel with the South boundary of Section 21, a distance of 117 feet; thence northerly and parallel with the East boundary line of above described Hargis tract, a distance of 30 feet; thence easterly 142 feet to the Northwest corner of City of Beaverton's Tract; thence southerly to the place of beginning, reserving an easement and right of way in common with others over the North 30 feet of the above described property, being a strip 30 x 142 feet, and is to be used for roadway purposes only.

SECTION 21

Township 1-S Range 1-W, W.M.

North

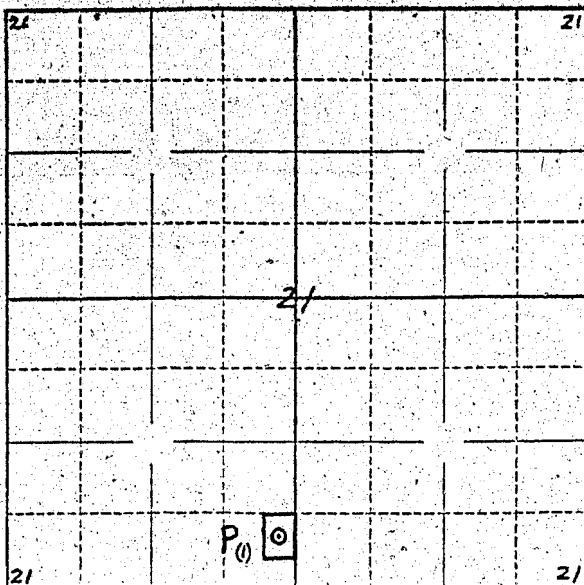

Locate well and acreage of irrigated land on plat.

Scale: 2" = 1 Mile

STATE OF OREGON

County of Washington } ss.

I, Robert O. Malsey, City Superintendent, being first duly sworn, do hereby certify that I have read the foregoing Registration Statement and that all of the items therein contained are true to the best of my knowledge and belief.

Robert O. Malsey
(Signature of Registrant)

Subscribed and sworn to before me this 6 day of February, 1957.

My commission expires June 20 1960 Alice B. Martin
(Notary Public)

(SEAL)

CERTIFICATE OF REGISTRATION

STATE OF OREGON } ss.
County of Marion

This is to certify that the foregoing Registration Statement was received in the office of the State Engineer on the 21st day of January, 1957, at 8:00 o'clock A. M. and has been duly recorded in said office in Book No. 2 of Registration Statements on page GR-328 G.

~~Construction shall be completed by x-x-x-x-x-x-x-x-10-x, and the water completely applied to beneficial use by x-x-x-x-x-x-x-x-19-x~~

Witness my hand this 1st day of April, 1957.

Lewis J. Stanley
(State Engineer)

By _____ (Deputy)

GR-328 G

\$ 26.00