

Registration Statement

OF CLAIMANT OF RIGHT TO APPROPRIATE GROUND WATER

TO THE STATE ENGINEER OF OREGON:

I, Joseph Henry and Rudolph Henry

of Rt 1 Brooks

(Mailing address)

County of Marion

State of Oregon, do hereby make application for a certificate of registration as evidence of a right to appropriate ground water.

1. Source from which water is withdrawn is pump well
(Flowing well, pump well, infiltration trench, or tunnel)

2. Location is: 2 miles east of Brooks, Ore.
(Approximate distance and direction from nearest city or town)

and is more particularly described as follows:

(a) 2340' S 67° 00' E from the NW Cor. sec 22 T2S R2W
(Give distance and bearing to corner of section or other legal subdivision)

being within NE 1/4 of the NW 1/4 of Sec. 22, Twp. 6 S, Rge. 21 W
(Smallest legal subdivision) (N. or S.) (E. or W.)

or (b) within limits of recorded platted property, town or city:

in Lot _____, Block _____ of _____
(Name of plat or addition)

County of _____
(If within city or town, give name)

3. Construction Work was begun on March 1910, was completed on March 1910
(Date) (Date)

and the ground water claimed was first used for the purposes set out below on March 1910
(Date)

since which time the water has been used continuously
(Continuously or intermittently)

from June 1910 to date
(Date) (Date)

4. Quantity of water claimed and used is 150 gallons per minute; _____ acre feet per year.

5. Purpose or Purposes for which water is used irrigation
(Domestic, irrigation, municipal, manufacturing, industrial, etc.)

6. Description of Well: Depth 52 feet. Type drilled
(Dug or drilled)

diameter 8 inches. Elevation of ground at well site 150 feet, mean sea level.
(As near as known)

Depth to water table 4.5 feet.

7. Capacity of Well: 150 g.p.m. with 15 feet drawdown.

_____ g.p.m. with _____ feet drawdown.


Date of test _____

If Flowing Well: Measured discharge _____ g.p.m. on _____
(Date)

Shut-in pressure at ground surface _____ lbs. per sq. in. on _____
(Date)

Water is controlled by _____
(Cap, valve, etc.)

Township 6S Range 2W, W.M.
North

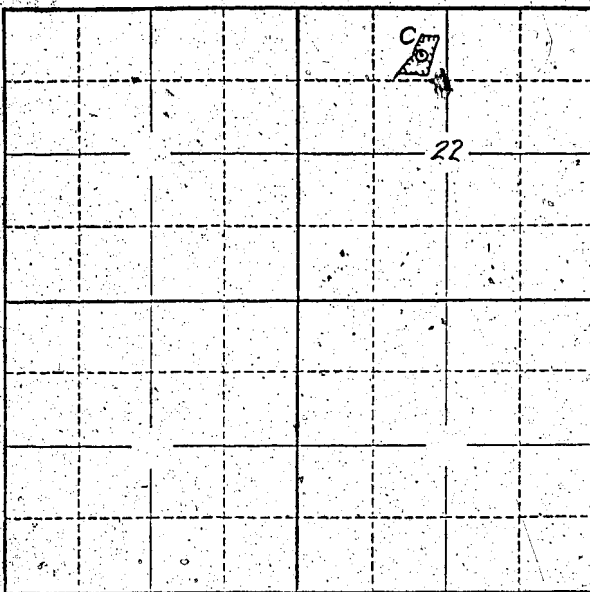

Locate well and acreage of irrigated land on plat.
Scale: 2" = 1 Mile

STATE OF OREGON

County of Marion } ss.

Joseph Kennedy being first duly sworn, do hereby certify that I have read the foregoing Registration Statement and that all of the items therein contained are true to the best of my knowledge and belief.

Joseph Kennedy
(Signature of Registrant)

Subscribed and sworn to before me this 31st day of July, 1958

My commission expires 12th June 1961 Wm. S. Whittemore
(Notary Public)

(SEAL)

CERTIFICATE OF REGISTRATION

STATE OF OREGON

County of Marion } ss.

This is to certify that the foregoing Registration Statement was received in the office of the State Engineer on the 31st day of July, 1958, at 2:40 o'clock P. M. and has been duly recorded in said office in Book No. 13 of Registration Statements on page GR 3172

Witness my hand this 18th day of June, 1959

Leora A. Altruby
(State Engineer)

By _____ (Deputy)

GR - 3172

\$15.00