

Registration Statement

OF CLAIMANT OF RIGHT TO APPROPRIATE GROUND WATER

TO THE STATE ENGINEER OF OREGON:

I, Paul Rigor

of Route 3 Box 585 Corvallis, Oregon County of Benton

(Mailing address)

State of Oregon, do hereby make application for a certificate of registration as evidence of a right to appropriate ground water.

1. Source from which water is withdrawn is Pump Well
(Flowing well, pump well, infiltration trench, or tunnel)

2. Location is: 7 Miles North of Monroe
(Approximate distance and direction from nearest city or town)

and is more particularly described as follows: Starting at common corner of sections 15-16

(a) 21-22, go 1535 ft south and then 342 ft west to well

(Give distance and bearing to corner of section or other legal subdivision)

being within SE 1/4 of NE 1/4 of Sec. 21, Twp. 13 S, Rge. 5 W
(Smallest legal subdivision) (N. or S.) (E. or W.)

or (b) within limits of recorded platted property, town or city:

in Lot _____, Block _____ of _____
(Name of plat or addition)

(If within city or town, give name)

3. Construction Work was begun on _____; was completed on 1953
(Date) (Date)

and the ground water claimed was first used for the purposes set out below on June 1953
(Date)

since which time the water has been used Intermittently
(Continuously or intermittently)

from June to October
(Date) (Date)

4. Quantity of water claimed and used is 100 gallons per minute; 32 1/2 acre feet per year.

5. Purpose or Purposes for which water is used Irrigation

(Domestic, irrigation, municipal, manufacturing, industrial, etc.)

6. Description of Well: Depth 35 feet. Type Drilled
(Dug or drilled)
diameter 2-6 inches. Elevation of ground at well site _____ feet, mean sea level.
(As near as known)

Depth to water table 6 feet.

7. Capacity of Well: _____ g.p.m. with _____ feet drawdown.
_____ g.p.m. with _____ feet drawdown.

Date of test Not tested

If Flowing Well: Measured discharge _____ g.p.m. on _____
(Date)

Shut-in pressure at ground surface _____ lbs. per sq. in. on _____
(Date)

Water is controlled by _____
(Cap, valve, etc.)

8. Casing: (Give diameter, commercial specifications and depth below ground surface of each casing size.) 2 wells 20 ft apart connected to one pump

6 inch diameter from to feet
 inch diameter from to feet
 inch diameter from to feet
 inch diameter from to feet

Describe and show depth of shoe, plug, adapter, liner or other details:

.....

.....

9. Perforated Casings or Screens:

Unknown from to

(Number per foot and size of perforations, or describe screen)

..... from to

..... from to

..... from to

10. Log of Well: (Describe each stratum or formation clearly, indicate if water bearing, and give thickness and depth as indicated.)

MATERIAL	Thickness (Feet)	Depth to Bottom (Feet)
None		

If log of well is not available, give name and address of driller. Unknown

11. Infiltration Trench: Covered or open

Dimensions: Length ft. Minimum depth ft. Maximum depth ft.

Bottom width ft. Discharge g.p.m. Date of test

12. Tunnel: Type of lining

Dimensions:
(Length, course, and cross sectional size)

Position of water bearing stratum with reference to portal of tunnel

Log of tunnel: (Preceding table for log of well may be used, if desired. Give footage from portal and character of materials, as pertinent.)

13. Pumping Equipment:

(a) Pump Farbanks Morse 2 inch outlet Capacity 100 g.p.m.
(Make, type and size)


(b) Motor Farbanks Morse Electric 5 Hp
(Type and horsepower)

14. Location of area irrigated or to be irrigated, or place of use if for purposes other than irrigation.

Township North or South	Range E. or W. of Willamette Meridian	Section	Forty-acre Tract	Number Acres To Be Irrigated	Date of Reclamation
13 S	5 W	22	NW $\frac{1}{4}$ of NW $\frac{1}{4}$	4.7	June 1953
13 S	5 W	22	SW $\frac{1}{4}$ of NW $\frac{1}{4}$	0.8	June 1953
13 S	5 W	21	SE $\frac{1}{4}$ of NE $\frac{1}{4}$	4.5	June 1953
13 S	5 W	21	NE $\frac{1}{4}$ of NE $\frac{1}{4}$	20.0	June 1953
			Total	30.0 Total	June 1953

15. If the ground water supply is supplemental to an existing water supply, identification of any application for a permit, permit, certificate or adjudicated right to appropriate water made or held by the registrant.

Township 135 Range 5 W, W.M.
North

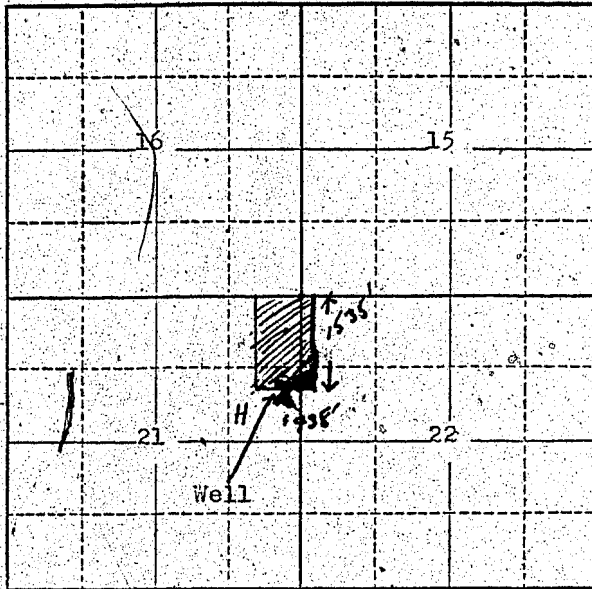

Locate well and acreage of irrigated land on plat.

Scale: 2" = 1 Mile

STATE OF OREGON

County of Benton

} ss.

I, Paul Rigor, being first duly sworn, do hereby certify that I have read the foregoing Registration Statement and that all of the items therein contained are true to the best of my knowledge and belief.

Paul Rigor
(Signature of Registrant)

Subscribed and sworn to before me this 8th day of February, 1960

NOTARY PUBLIC FOR OREGON

My commission expires March 29, 1960

Ernest Gault
(Notary Public)

(SEAL)

CERTIFICATE OF REGISTRATION

STATE OF OREGON

County of Marion

} ss.

This is to certify that the foregoing Registration Statement was received in the office of the State Engineer on the 1st day of August, 1958, at 8:00 o'clock A.M. and has been duly recorded in said office in Book No. 13 of Registration Statements on page GR-3174

Witness my hand this 15th day of February, 1960

Flora A. Stanley
(State Engineer)

By _____ (Deputy)

\$15.00

GR-3174