

Registration Statement

OF CLAIMANT OF RIGHT TO APPROPRIATE GROUND WATER

TO THE STATE ENGINEER OF OREGON:

I, PHILIP B. GRENON

of ROUTE 1 BOX 267

(Mailing address)

County of LANE

State of OREGON, do hereby make application for a certificate of registration as evidence of a right to appropriate ground water.

1. Source from which water is withdrawn is PUMP WELL

(Flowing well, pump well, infiltration trench, or tunnel)

2. Location is: 1380' W & 1525' N OF SE 8 MILES NW of EUGENE

(Approximate distance and direction from nearest city or town)

and is more particularly described as follows:

(a) 1380' W & 1525' N OF SE CORNER SECTION 13

(Give distance and bearing to corner of section or other legal subdivision)

being within NW 1/4 of SE 1/4 of Sec. 13, Twp. 17 S, Rge. 5 W

(Smallest legal subdivision)

(T²⁰ or S)

(R²⁰ or W)

or (b) within limits of recorded platted property, town or city:

in Lot _____, Block _____ of _____

(Name of plat or addition)

(If within city or town, give name)

County of _____

3. Construction Work was begun on MARCH 1950; was completed on MARCH 1952

(Date)

(Date)

and the ground water claimed was first used for the purposes set out below on MARCH 1950

(Date)

since which time the water has been used CONTINUOUSLY

(Continuously or intermittently)

from ALL YEAR to 1957

(Date)

(Date)

4. Quantity of water claimed and used is 400-500 gallons per minute; 17 1/2 acre feet per year.

5. Purpose or Purposes for which water is used IRRIGATION - exempt

(Domestic, irrigation, municipal, manufacturing, industrial, etc.)

6. Description of Well: Depth 42 feet. Type DRILLED

(Dug or drilled)

diameter 4 inches. Elevation of ground at well site 420 feet, mean sea level.

(As near as known)

Depth to water table 3 feet.

7. Capacity of Well: unknown g.p.m. with _____ feet drawdown.

_____ g.p.m. with _____ feet drawdown.

Date of test NONE

If Flowing Well: Measured discharge _____ g.p.m. on _____

(Date)


Shut-in pressure at ground surface _____ lbs. per sq. in. on _____

(Date)

Water is controlled by _____

(Cap, valve, etc.)

Township 17S Range 5W W.M.
North

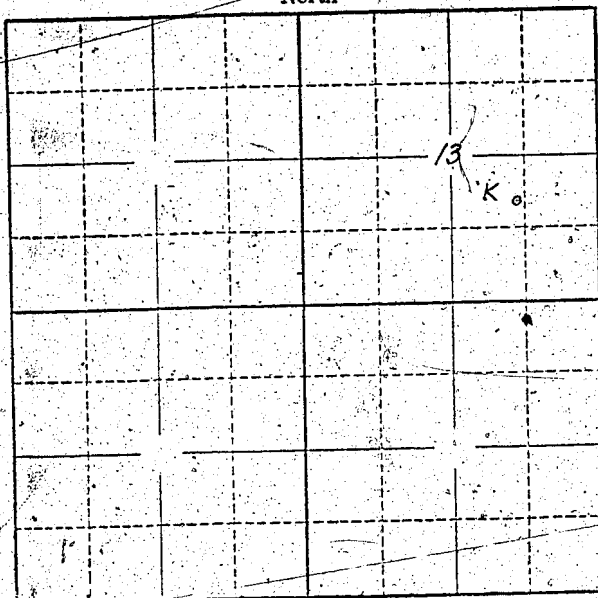

Locate well and acreage of irrigated land on plat.
Scale: 2" = 1 Mile

STATE OF OREGON

County of LANE

I, PHILIP B. GRENON, being first duly sworn, do hereby certify that I have read the foregoing Registration Statement and that all of the items therein contained are true to the best of my knowledge and belief.

(Signature of Registrant)

Subscribed and sworn to before me this _____ day of _____, 1958

My commission expires 4.20.61

(Notary Public)

(SEAL)

CERTIFICATE OF REGISTRATION

STATE OF OREGON

County of Marion

This is to certify that the foregoing Registration Statement was received in the office of the State Engineer on the 31 day of July, 1958, at 9:00 o'clock A. M. and has been duly recorded in said office in Book No. 19 of Registration Statements on page GR-3175

Witness my hand this 20th day of July, 1959

(State Engineer)

By _____ (Deputy)

GR - 3175

\$15.00