

Registration Statement

OF CLAIMANT OF RIGHT TO APPROPRIATE GROUND WATER

TO THE STATE ENGINEER OF OREGON:

I, Herman E. Hood
of Route 1 Box 227 Minnville County of Washburn
(Mailing address)

State of Oregon, do hereby make application for a certificate of registration as evidence of a right to appropriate ground water.

1. Source from which water is withdrawn is Pump well
(Flowing well, pump well, infiltration trench, or tunnel)

2. Location is: 2 mi NW of Unity
(Approximate distance and direction from nearest city or town)

and is more particularly described as follows: 22 mi NW and 2500 ft

(a) 500 feet east of the SW corner of the 1/2 of the 1/4 section
(Give distance and bearing to corner of section or other legal subdivision)
being within 41 of Sec. 24 Twp. 5S Rge. 5W
(Smallest legal subdivision) (N. or S.) (E. or W.)

or (b) within limits of recorded platted property, town or city:

in Lot _____ Block _____ of _____
(Name of plat or addition)

County of Washburn
(If within city or town, give name)

3. Construction Work was begun on June 9, 1935; was completed on July 1, 1935
(Date) (Date)

and the ground water claimed was first used for the purposes set out below on July 1, 1935
(Date)

since which time the water has been used Intermittently
(Continuously or Intermittently)

from 1939 to 1955
(Date) (Date)

4. Quantity of water claimed and used is 200 gallons per minute; _____ acre feet per year.

5. Purpose or Purposes for which water is used Irrigation
(Domestic, irrigation, municipal, manufacturing, industrial, etc.)

6. Description of Well: Depth 28 feet. Type Drilled
(Dug or drilled)

diameter 12 inches. Elevation of ground at well site 125 feet, mean sea level.
(As near as known)

Depth to water table 21 feet.

7. Capacity of Well: 200 g.p.m. with 15 feet drawdown.

_____ g.p.m. with _____ feet drawdown.


Date of test July 1935

If Flowing Well: Measured discharge _____ g.p.m. on _____
(Date)

Shut-in pressure at ground surface _____ lbs. per sq. in. on _____
(Date)

Water is controlled by _____
(Cap, valve, etc.)

524 Township 55 Range 5W, W.M. North

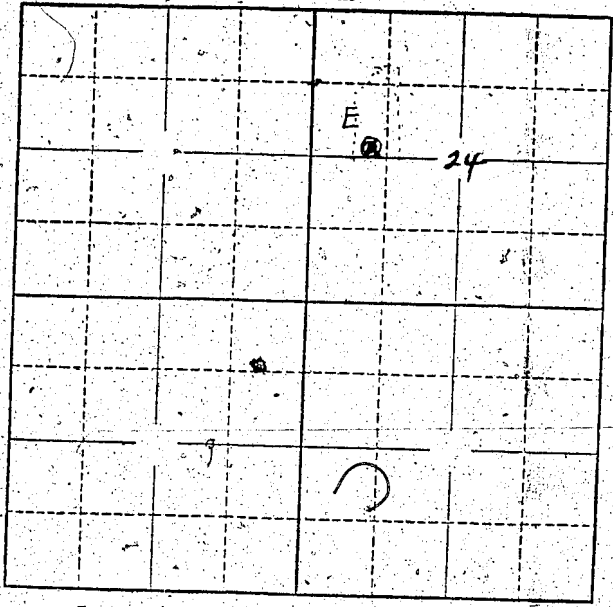

Locate well and acreage of irrigated land on plat.
Scale: 2" = 1 Mile

STATE OF OREGON

County of Yamhill } ss.

I, _____, being first duly sworn, do hereby certify that I have read the foregoing Registration Statement and that all of the items therein contained are true to the best of my knowledge and belief.

Herman E. Meind
(Signature of Registrant)

Subscribed and sworn to before me this 29th day of July, 1958.

My commission expires May 20, 1959.

Arthur M. [illegible]
(Notary Public)

(SEAL)

CERTIFICATE OF REGISTRATION

STATE OF OREGON }
County of Marion } ss.

This is to certify that the foregoing Registration Statement was received in the office of the State Engineer on the 31 day of July, 1958, at 8:00 o'clock A.M. and has been duly recorded in said office in Book No. 13 of Registration Statements on page GR-3181

Witness my hand this 20th day of July, 1959

\$15.00

Wm. A. [illegible]
(State Engineer)

By _____
(Deputy)