

Registration Statement

OF CLAIMANT OF RIGHT TO APPROPRIATE GROUND WATER

TO THE STATE ENGINEER OF OREGON:

I, Lawrence L. Etzel

of Route 3, Box 89, Lebanon County of Linn
(Mailing address)

State of Oregon do hereby make application for a certificate of registration as evidence of a right to appropriate ground water.

- Source from which water is withdrawn is Pump well # 2
(Flowing well, pump well, infiltration trench, or tunnel)
- Location is: 7 Miles North of Lebanon, Oregon
(Approximate distance and direction from nearest city or town)

and is more particularly described as follows:

(a) 660' N. and 2079' W. of SE corner S. 11, T. 11 S, R. 2 W
(Give distance and bearing to corner of section or other legal subdivision)

being within SW 1/4 of SE 1/4 of Sec. 11, Twp. 11S, Rge. 2 W
(Smallest legal subdivision) (N. or S.) (E. or W.)

or (b) within limits of recorded platted property, town or city:

in Lot _____, Block _____ of _____
(Name of plat or addition)

County of Linn
(If within city or town, give name)

3. Construction Work was begun on May 20, 1951; was completed on May 25, 1951
(Date) (Date)

and the ground water claimed was first used for the purposes set out below on June 5, 1951
(Date)

since which time the water has been used Continuously
(Continuously or Intermittently)

from June 5, 1951 to present time
(Date) (Date)

4. Quantity of water claimed and used is 105 gallons per minute; 129.0 acre feet per year.

5. Purpose or Purposes for which water is used Irrigation
(Domestic, irrigation, municipal, manufacturing, industrial, etc.)

6. Description of Well: Depth 45 feet, Type Drilled
(Dug or drilled)

diameter 8 inches. Elevation of ground at well site 250 feet, mean sea level.
(As near as known)

Depth to water table 3 feet.

7. Capacity of Well: 105 g.p.m. with 40 feet drawdown.

_____ g.p.m. with _____ feet drawdown.


Date of test _____

If Flowing Well: Measured discharge _____ g.p.m. on _____
(Date)

Shut-in pressure at ground surface _____ lbs. per sq. in. on _____
(Date)

Water is controlled by _____
(Cap, valve, etc.)

Township 11 S Range 2 W, W.M.
North

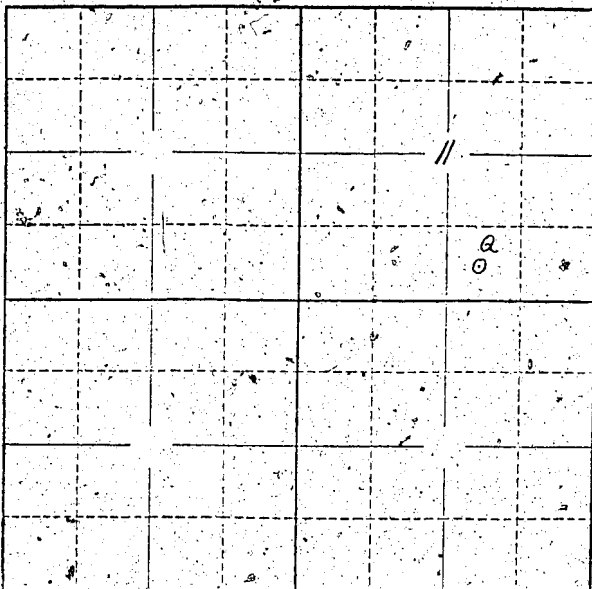

Locate well and acreage of irrigated land on plat.
Scale: 2" = 1 Mile

STATE OF OREGON

County of Linn

ss.

I, Lawrence L. Etzel being first duly sworn, do hereby certify that I have read the foregoing Registration Statement and that all of the items therein contained are true to the best of my knowledge and belief.

Lawrence L. Etzel
(Signature of Registrant)

Subscribed and sworn to before me this _____ day of _____ 19__

My commission expires MY COMMISSION EXPIRES MAY 22, 1967

William E. Phillips
(Notary Public)

(SEAL)

CERTIFICATE OF REGISTRATION

STATE OF OREGON

County of Marion

ss.

This is to certify that the foregoing Registration Statement was received in the office of the State Engineer on the 22nd day of July, 1959, at _____ o'clock _____ M. and has been duly recorded in said office in Book No. 13 of Registration Statements on page GR-3181

Witness my hand this 20th day of July, 1959

W. A. Otterly
(State Engineer)

By _____

(Deputy)

GR-3184