

# Registration Statement

## OF CLAIMANT OF RIGHT TO APPROPRIATE GROUND WATER



TO THE STATE ENGINEER OF OREGON:

I, William M. Mitchell

of Route 2, Box 183, Lebanon  
(Mailing address)

County of Linn

State of Oregon

do hereby make application for a certificate of registration as evidence of a right to appropriate ground water.

1. Source from which water is withdrawn is Pump well  
(Flowing well, pump well, infiltration trench, or tunnel)

2. Location is: 1 3/4 miles North of Lebanon, Oregon  
(Approximate distance and direction from nearest city or town)

and is more particularly described as follows:

(a) N. 18° 30' W. 7.5 chains from SE corner of S. 31, T. 119, R. 2  
(Give distance and bearing to corner of section or other legal subdivision)

being within SE 1/4 of SE 1/4 of Sec. 34 Twp. 11 S Rge. 2 W  
(Smallest legal subdivision) (N. or S.) (E. or W.)

or (b) within limits of recorded platted property, town or city:

in Lot \_\_\_\_\_ Block \_\_\_\_\_ of \_\_\_\_\_  
(Name of plat or addition)

County of Linn  
(If within city or town, give name)

3. Construction Work was begun on 1952; was completed on 1952  
(Date) (Date)

and the ground water claimed was first used for the purposes set out below on June 1952  
(Date)

since which time the water has been used Continuously  
(Continuously or Intermittently)

from June 1952 to present time  
(Date) (Date)

4. Quantity of water claimed and used is 200 gallons per minute; 88.6 acre feet per year.

5. Purpose or Purposes for which water is used Irrigation  
(Domestic, irrigation, municipal, manufacturing, industrial, etc.)

6. Description of Well: Depth 108 feet. Type drilled  
(Dug or drilled)

diameter 8 inches. Elevation of ground at well site 220 feet, mean sea level.  
(As near as known)

Depth to water table 15 feet.

7. Capacity of Well: \_\_\_\_\_ g.p.m. with \_\_\_\_\_ feet drawdown.

\_\_\_\_\_ g.p.m. with \_\_\_\_\_ feet drawdown.

Date of test Not tested

If Flowing Well: Measured discharge \_\_\_\_\_ g.p.m. on \_\_\_\_\_  
(Date)

Shut-in pressure at ground surface \_\_\_\_\_ lbs. per sq. in. on \_\_\_\_\_  
(Date)

Water is controlled by \_\_\_\_\_  
(Cap, valve, etc.)

8. Casing: (Give diameter, commercial specifications and depth below ground surface of each casing size.)

8 inch diameter Steel casing from 1 to 108 feet  
 inch diameter from to feet  
 inch diameter from to feet  
 inch diameter from to feet

Describe and show depth of shoe, plug, adapter, liner or other details:

9. Perforated Casings or Screens:

Slot perforations from 12 to 50  
(Number per foot and size of perforations, or describe screen)

Slot perforations from 90 to 108

from to

from to

10. Log of Well: (Describe each stratum or formation clearly, indicate if water bearing, and give thickness and depth as indicated.)

MATERIALS	Thickness (Feet)	Depth to Bottom (Feet)
Not available		

If log of well is not available, give name and address of driller, Erico Mas...

11. Infiltration Trench: Covered or open \_\_\_\_\_  
 Dimensions: Length \_\_\_\_\_ ft. Minimum depth \_\_\_\_\_ ft. Maximum depth \_\_\_\_\_ ft.  
 Bottom width \_\_\_\_\_ ft. Discharge \_\_\_\_\_ g.p.m. Date of test \_\_\_\_\_

12. Tunnel: Type of lining \_\_\_\_\_  
 Dimensions: \_\_\_\_\_  
(Length, course, and cross sectional size)  
 Position of water bearing stratum with reference to portal of tunnel \_\_\_\_\_

Log of tunnel: (Preceding table for log of well may be used, if desired. Give footage from portal and character of materials, as pertinent.)

13. Pumping Equipment:  
 (a) Pump Goold 22" centrifugal Capacity \_\_\_\_\_ g.p.m.  
(Make, type and size)  
 (b) Motor 1/2 H.P. electric  
(Type and horsepower)


14. Location of area irrigated or to be irrigated, or place of use if for purposes other than irrigation.

Township North or South	Range E. or W. of Williams Meridian	Section	Forty-acre Tract	Number Acres To Be Irrigated	Date of Reclamation
11 S.	2 W.	34	NE 1/4 of S34	3.3	
11 S.	2 W.	34	SE 1/4 of S34	39.7	
11 S.	2 W.	35	NE 1/4 of S35	1.0	
11 S.	2 W.	35	SE 1/4 of S35	6.2	

All right, title and interest in and to the following described property: Beginning at the Northeast corner of the D.L.C. of John H. Settle and the heirs at law of Sarah E. Settle, his wife, same being Not. No. 1205 and Claim No. 65, in Twp. 11 S., R. 2 W., and Claim No. 81 in Twp. 12 S., R. 2 W. of the Will. Mer., in Linn County, Oregon; and running thence South 16.33 chains to a point 15.13 chains North of the Southeast corner of said Claim No. 81; thence West 19.00 chains; thence North 19° East 8.79 chains to the center of a slough; thence along the center of said slough as follows: North 45° W. 5.30 chains; North 24 3/4° W. 4.65 chains to the North boundary line of said Claim No. 65; thence E. 21.80 chains to the place of beginning, containing 30.11 acres more or less, all of said land lying and being in Linn County, Oregon.


15. If the ground water supply is supplemental to an existing water supply, identification of any application for a permit, permit, certificate or adjudicated right to appropriate water made or held by the registrant.

Township 11 S Range 2 W W.M.  
North

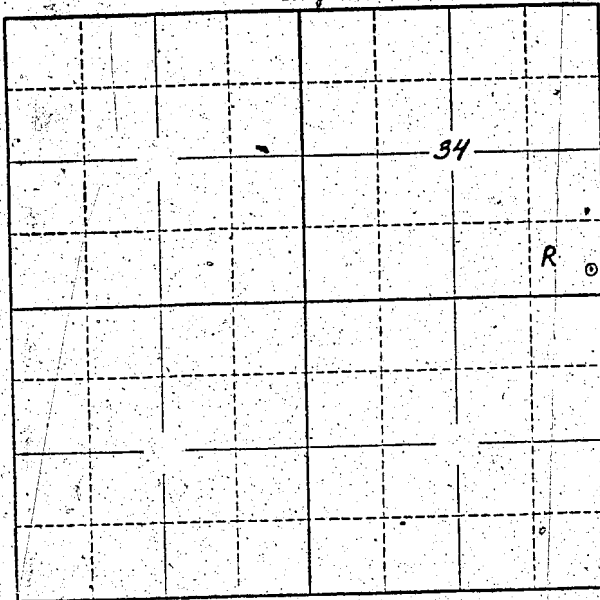

Locate well and acreage of irrigated land on plat.  
Scale: 2" = 1 Mile

STATE OF OREGON

County of Linn } ss.

I, William M. Mitchell, being first duly sworn, do hereby certify that I have read the foregoing Registration Statement and that all of the items therein contained are true to the best of my knowledge and belief.

*William M. Mitchell*  
(Signature of Registrant)

Subscribed and sworn to before me this 15 day of July, 1958

My commission expires January 21, 1961

*[Signature]*  
(Notary Public)

(SEAL)

**CERTIFICATE OF REGISTRATION**

STATE OF OREGON

County of Marion } ss.

This is to certify that the foregoing Registration Statement was received in the office of the State Engineer on the 31 day of July, 1958, at 8:00 o'clock A.M. and has been duly recorded in said office in Book No. 13 of Registration Statements on page GR-319-1

Witness my hand this 20th day of July, 1959

*[Signature]*  
(State Engineer)

By \_\_\_\_\_ (Deputy)

7/15-00

GR-319-1