

# Registration Statement

## OF CLAIMANT OF RIGHT TO APPROPRIATE GROUND WATER

TO THE STATE ENGINEER OF OREGON:

I, Elmer C. Hathaway

of Rte #3 Bayview, Corvallis County of Benton

State of Oregon, do hereby make application for a certificate of registration as evidence of a right to appropriate ground water.

1. Source from which water is withdrawn is Pump Well

2. Location is: 6 miles S. East from Corvallis Ore

and is more particularly described as follows:

(a) 792' N 40° 14' E of SW cor. Sec. 14

being within SE 4 SW 4 of Sec. 14, Twp. 12S, Rge. 11E

or (b) within limits of recorded platted property, town or city:

in Lot \_\_\_\_\_, Block \_\_\_\_\_ of \_\_\_\_\_

(If within city or town, give name) \_\_\_\_\_ County of \_\_\_\_\_

3. Construction Work was begun on June 1954; was completed on June 1954

and the ground water claimed was first used for the purposes set out below on June 1954

since which time the water has been used continuously during summer

from June 1954 to July 1958

4. Quantity of water claimed and used is 85 gallons per minute; \_\_\_\_\_ acre feet per year.

5. Purpose or Purposes for which water is used irrigating pastures

6. Description of Well: Depth 21 feet. Type drilled

diameter 6 inches. Elevation of ground at well-site 720 feet, mean sea level.

Depth to water table at 2 feet.

7. Capacity of Well: 100+ g.p.m. with 2 feet drawdown.

\_\_\_\_\_ g.p.m. with \_\_\_\_\_ feet drawdown.

Date of test \_\_\_\_\_

If Flowing Well: Measured discharge \_\_\_\_\_ g.p.m. on \_\_\_\_\_

Shut-in pressure at ground surface \_\_\_\_\_ lbs. per sq. in. on \_\_\_\_\_


Water is controlled by \_\_\_\_\_

(Cap, valve, etc.)





Township 12.5 Range 4W, W.M.  
North

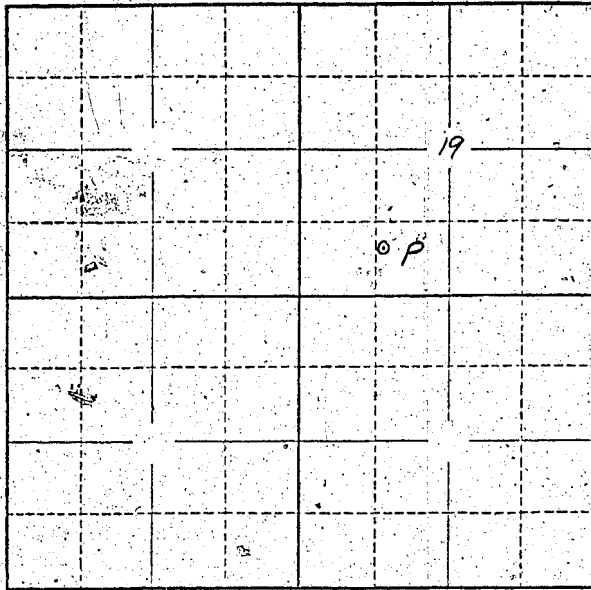

Locate well and acreage of irrigated land on plat.  
Scale: 2" = 1 Mile

STATE OF OREGON }  
County of BENTON } ss.

I, ELMER C. HATHAWAY, being first duly sworn, do hereby certify that I have read the foregoing Registration Statement and that all of the items therein contained are true to the best of my knowledge and belief.

Elmer C. Hathaway  
(Signature of Registrant)

Subscribed and sworn to before me this 24th day of July, 1955  
My commission expires Nov. 23, 1961

(SEAL)

[Signature]  
(Notary Public)

**CERTIFICATE OF REGISTRATION**

STATE OF OREGON }  
County of Marion } ss.

This is to certify that the foregoing Registration Statement was received in the office of the State Engineer on the 31st day of July, 1958, at 2:00 o'clock P.M. and has been duly recorded in said office in Book No. 13 of Registration Statements on page GR-3192

Witness my hand this 20th day of July, 1959.

[Signature]  
(State Engineer)

By \_\_\_\_\_  
(Deputy)

#15.00