

Registration Statement

OF CLAIMANT OF RIGHT TO APPROPRIATE GROUND WATER

TO THE STATE ENGINEER OF OREGON:

I, Elmer C. Halkaway
of Route #3 Box 406 Corvallis County of Benton
(Mailing address)

State of Oregon do hereby make application for a certificate of registration as evidence of a right to appropriate ground water.

1. Source from which water is withdrawn is Pump well #1
(Flowing well, pump well, infiltration trench, or tunnel)

2. Location is: 6 miles S.E. from Corvallis, Ore.
(Approximate distance and direction from nearest city or town)

and is more particularly described as follows:

(a) 792' N 0° 00' 00" E of SW cor. Sec 16
(Give distance and bearing to corner of section or other legal subdivision)

being within SW 1/4 SW 1/4 of Sec. 17, Twp. 12S, Rge. 7E
(Smallest legal subdivision) (N. or S.) (E. or W.)

or (b) within limits of recorded platted property, town or city:

in Lot _____, Block _____ of _____
(Name of plat or addition)

County of _____
(If within city or town, give name)

3. Construction Work was begun on June 48, was completed on June 1948
(Date) (Date)

and the ground water claimed was first used for the purposes set out below on July 10 48
(Date)

since which time the water has been used Continually during summer
(Continuously or intermittently)

from June 1948 to July 1958
(Date) (Date)

4. Quantity of water claimed and used is _____ gallons per minute; _____ acre feet per year.

5. Purpose or Purposes for which water is used irrigating pasture
(Domestic, irrigation, municipal, manufacturing, industrial, etc.)

6. Description of Well: Depth 20 feet. Type drilled
(Dug or drilled)

diameter 5 inches. Elevation of ground at well site 210 feet, mean sea level.
(As near as known)

Depth to water table 12 feet.

7. Capacity of Well: 125 g.p.m. with _____ feet drawdown.
_____ g.p.m. with _____ feet drawdown.

Date of test 7

If Flowing Well: Measured discharge _____ g.p.m. on _____
(Date)

Shut-in pressure at ground surface _____ lbs. per sq. in. on _____
(Date)

Water is controlled by _____
(Cap, valve, etc.)

8. **Casing:** (Give diameter, commercial specifications and depth below ground surface of each casing size.)

5 inch diameter from 0 to feet
 inch diameter from to feet
 inch diameter from to feet
 inch diameter from to feet

Describe and show depth of shoe, plug, adapter, liner or other details:

.....

9. **Perforated Casings or Screens:**

No data available

(Number per foot and size of perforations, or describe screen)

..... from to
 from to
 from to
 from to

10. **Log of Well:** (Describe each stratum or formation clearly, indicate if water bearing, and give thickness and depth as indicated.)

MATERIAL	Thickness (Feet)	Depth to Bottom (Feet)
<i>Thin Bottom</i>	<i>10</i>	
<i>gravel</i>		

If log of well is not available, give name and address of driller. *Philcorath*

11. Infiltration Trench: Covered or open
 Dimensions: Length ft. Minimum depth ft. Maximum depth ft.
 Bottom width ft. Discharge g.p.m. Date of test

12. Tunnel: Type of lining
 Dimensions: (Length, course, and cross sectional size)
 Position of water bearing stratum with reference to portal of tunnel

Log of tunnel: (Preceding table for log of well may be used, if desired. Give footage from portal and character of materials, as pertinent.)


13. Pumping Equipment:
 (a) Pump *Wearman Pump* Capacity g.p.m.
(Make, type and size)
 (b) Motor *GE Motor 5HP*
(Type and horsepower)

14. Location of area irrigated or to be irrigated, or place of use if for purposes other than irrigation.

Township North or South	Range E. or W. of Willamette Meridian	Section	Forty-acre Tract	Number Acres To Be Irrigated	Date of Reclamation
125	416	19	SW 1/4 SW 1/4	11.5	
"	"	"	SW 1/4 SW 1/4	1.5	
				<u>13.0</u>	

15. If the ground water supply is supplemental to an existing water supply, identification of any application for a permit, certificate or adjudicated right to appropriate water made or held by the registrant.
This includes location and course by water in Highway Statement

Township 12^S Range 4^W, W.M.
North

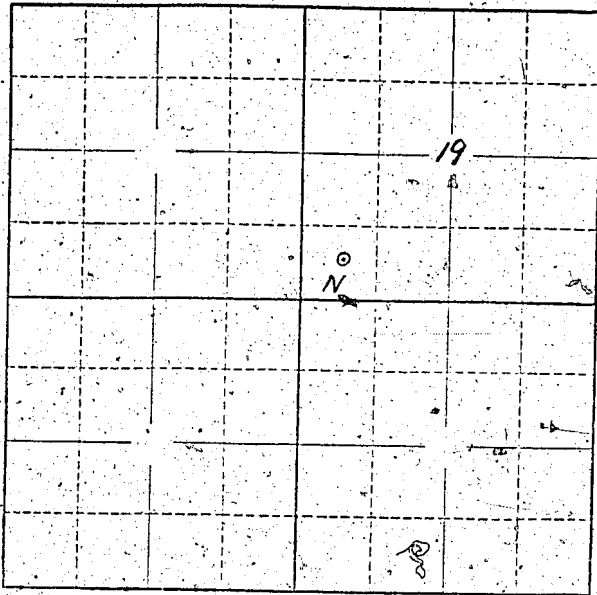

Locate well and acreage of irrigated land on plat.
Scale: 2" = 1 Mile

STATE OF OREGON

County of VENICUM } ss.

I, FLMIR C. HANNA, being first duly sworn, do hereby certify that I have read the foregoing Registration Statement and that all of the items therein contained are true to the best of my knowledge and belief.

[Handwritten Signature]
(Signature of Registrant)

Subscribed and sworn to before me this 10th day of July, 1959

My Commission Expires Nov. 23, 1961

My commission expires _____
(Notary Public)

(SEAL)

CERTIFICATE OF REGISTRATION

STATE OF OREGON

County of Marion } ss.

This is to certify that the foregoing SR Registration Statement was received in the office of the State Engineer on the _____ day of _____, 1959, at _____ o'clock _____ M. and has been duly recorded in said office in Book No. 13 of Registration Statements on page GR 3193

Witness my hand this 20th day of July, 1959

\$15.00

(State Engineer)

By _____
(Deputy)

GR - 3193