

Registration Statement

OF CLAIMANT OF RIGHT TO APPROPRIATE GROUND WATER

TO THE STATE ENGINEER OF OREGON:

I, Vernal D. Wilsonof Box 294 Boring

(Mailing address)

County of ClackamasState of Oregon, do hereby make application for a certificate of registration as evidence of a right to appropriate ground water.1. Source from which water is withdrawn is Pump Well
(Flowing well, pump well, infiltration trench, or tunnel)2. Location is: one mile and 1/2 N.W. of Boring
(Approximate distance and direction from nearest city or town)and is more particularly described as follows: 275 feet east of Section 36(a) 542 feet from S.E. corner
(Give distance and bearing to corner of section or other legal subdivision)being within LOT 11 - NE 1/4 of SE 1/4 of Sec 36, Twp. 4S, Rge. 3E
(Smallest legal subdivision) (N. or S.) (E. or W.)or (b) within limits of recorded platted property, town or city: Oregon Cityin Lot 11, Block Coolidge Home
(Name of plat or addition)(If within city or town, give name) County of Coolidge Home Division3. Construction Work was begun on APR 53; was completed on APR 1953
(Date) (Date)and the ground water claimed was first used for the purposes set out below on June 1, 1953
(Date)since which time the water has been used continuously
(Continuously or intermittently)from June 1, 1953 to present
(Date) (Date)4. Quantity of water claimed and used is 100 gallons per minute; _____ acre
feet per year.5. Purpose or Purposes for which water is used Irrigation

(Domestic, irrigation, municipal, manufacturing, industrial, etc.)

6. Description of Well: Depth 222.5 feet. Type Drilled

(Dug or drilled)

diameter 8 inches. Elevation of ground at well site 200 feet, mean sea level.
(As near as known)Depth to water table 60 feet.7. Capacity of Well: 250+ g.p.m. with 75 feet drawdown.

_____ g.p.m. with _____ feet drawdown.

Date of test April 1953If Flowing Well: Measured discharge _____ g.p.m. on _____
(Date)Shut-in pressure at ground surface _____ lbs. per sq. in. on _____
(Date)controlled by _____
(Cap. valve, etc.)

inch diameter	from	to	feet
inch diameter	from	to	feet
inch diameter	from	to	feet
inch diameter	from	to	feet

9. **Perforated Castings or Screens:**

(Number, foot and size of perforations, or describe screen)

from _____ to _____

from to

from to

from _____ to _____

[illegible]

11. **Infiltration Trench:** Covered or open

Bottom width ft. Discharge g.p.m. Date of test

12. **Tunnel:** Type of lining

Dimensions:
(Length, course, and cross sectional size)

Position of water bearing stratum with reference to portal of tunnel

13. Pumping Equipment:


(a) Pump Jacuzzi Turbine 3" Capacity 200 g.p.m.

(b) Motor Electric - 7 1/2 H.P.
(Type and horsepower)

[illegible]

GR 3194

Township 1S Range 3E W.M.
North

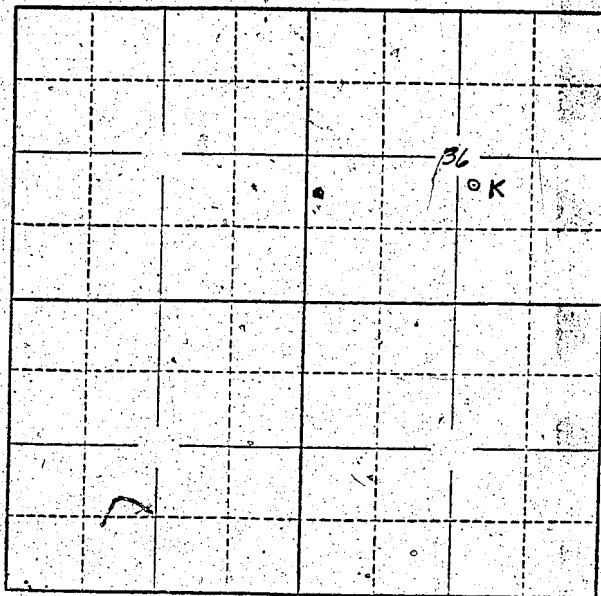

Locate well and acreage of irrigated land on plat.
Scale: 2" = 1 Mile.

STATE OF OREGON



(Signature of Registrant)

Subscribed and sworn to before me this 21 day of July, 1957.

My commission expires July 5, 1959

[Signature]
(Notary Public)

(SEAL)

CERTIFICATE OF REGISTRATION

STATE OF OREGON

County of Marion } ss.

This is to certify that the foregoing Registration Statement was received in the office of the State Engineer on the 31st day of July, 1957, at 2:00 o'clock P.M. and has been duly recorded in said office in Book No. 13 of Registration Statements on page GR 3194

Witness my hand this 20th day of July, 1959.

Lawrence A. Stanley
(State Engineer)

By _____
(Deputy)

GR - 3194

4/5.00