

# Registration Statement

## OF CLAIMANT OF RIGHT TO APPROPRIATE GROUND WATER

TO THE STATE ENGINEER OF OREGON:

I, G M Kragg  
of Marion Co R.R. 1 County of Benton  
(Mailing address)

State of Oregon, do hereby make application for a certificate of registration as evidence of a right to appropriate ground water:

1. Source from which water is withdrawn is Pump Well  
(Flowing well, pump well, infiltration trench, or tunnel)

2. Location is: 6 miles NE of Marion  
(Approximate distance and direction from nearest city or town)

and is more particularly described as follows:

(a) S 1360 FT 92 53° E S 12 Corner Sec 7 TR 14 S R 4 W  
(Give distance and bearing to corner of section or other legal subdivision)

being within S 12 1/4 Sec 7 of Sec. 7, Twp. 14 S, Rge. 4 W  
(Smallest legal subdivision) (N. or S.) (E. or W.)

or (b) within limits of recorded platted property, town or city:

in Lot \_\_\_\_\_, Block \_\_\_\_\_ of \_\_\_\_\_  
(Name of plat or addition)

County of \_\_\_\_\_  
(If within city or town, give name)

3. Construction Work was begun on 1-25-21; was completed on 19-52  
(Date) (Date)

and the ground water claimed was first used for the purposes set out below on 19-52  
(Date)

since which time the water has been used not used  
(Continuously or intermittently)

from intermittently July to Sept  
(Date) (Date)

4. Quantity of water claimed and used is 210 gallons per minute; 85 acre feet per year.

5. Purpose or Purposes for which water is used irrigation

(Domestic, irrigation, municipal, manufacturing, industrial, etc.)

6. Description of Well: Depth 22 feet, Type drum  
(Dug or drilled)

diameter 5 inches. Elevation of ground at well-site 225 feet, mean sea level.  
(As near as known)

Depth to water table 16 feet.

7. Capacity of Well: not known g.p.m. with \_\_\_\_\_ feet drawdown.

\_\_\_\_\_ g.p.m. with \_\_\_\_\_ feet drawdown.

Date of test 1955

If Flowing Well: Measured discharge \_\_\_\_\_ g.p.m. on \_\_\_\_\_  
(Date)

Shut-in pressure at ground surface \_\_\_\_\_ lbs. per sq. in. on \_\_\_\_\_  
(Date)

Water is controlled by \_\_\_\_\_  
(Cap, valve, etc.)

8. Casing: (Give diameter, commercial specifications and depth below ground surface of each casing size.)

5 inch diameter ..... from 0 to 22 feet  
..... inch diameter ..... from ..... to ..... feet  
..... inch diameter ..... from ..... to ..... feet  
..... inch diameter ..... from ..... to ..... feet

Describe and show depth of shoe, plug, adapter, liner or other details:

9. Perforated Casings or Screens:

..... from 12' to 4'  
(Number per foot and size of perforations, or describe screen)  
..... from ..... to .....  
..... from ..... to .....  
..... from ..... to .....

10. Log of Well: (Describe each stratum or formation clearly, indicate if water bearing, and give thickness and depth as indicated.)

MATERIAL	Thickness (Feet)	Depth to Bottom (Feet)
No information		

If log of well is not available, give name and address of driller. Frank Yelloway (Retired)  
Family of Maria On

11. Infiltration Trench: Covered or open .....  
 Dimensions: Length ..... ft. Minimum depth ..... ft. Maximum depth ..... ft.  
 Bottom width ..... ft. Discharge ..... g.p.m. Date of test .....

12. Tunnel: Type of lining .....  
 Dimensions: .....  
 (Length, course, and cross sectional size)  
 Position of water bearing stratum with reference to portal of tunnel .....

Log of tunnel: (Preceding table for log of well may be used, if desired. Give footage from portal and character of materials, as pertinent.)


13. Pumping Equipment:  
 (a) Pump 2<sup>nd</sup> centrifugal Capacity 300 g.p.m.  
 (Make, type and size)  
 (b) Motor Tractor 25 HP  
 (Type and horsepower)

14. Location of area irrigated or to be irrigated, or place of use if for purposes other than irrigation.

Township North or South	Range E. or W. of Willamette Meridian	Section	Forty-acre Tract	Number Acres To Be Irrigated	Date of Reclamation
14 S	4 W	7	SE 1/4 7 S 26 1/4	23.5	1952
"	"	"	SE 1/4 7 S 26 1/4	14.5	"
"	"	"	SW 1/4 7 S 26 1/4	2.5	"
			Total	40	"
				40	

15. If the ground water supply is supplemental to an existing water supply, identification of any application for a permit, permit, certificate or adjudicated right to appropriate water made or held by the registrant.

Township 143 Range 4W, W.M.  
North

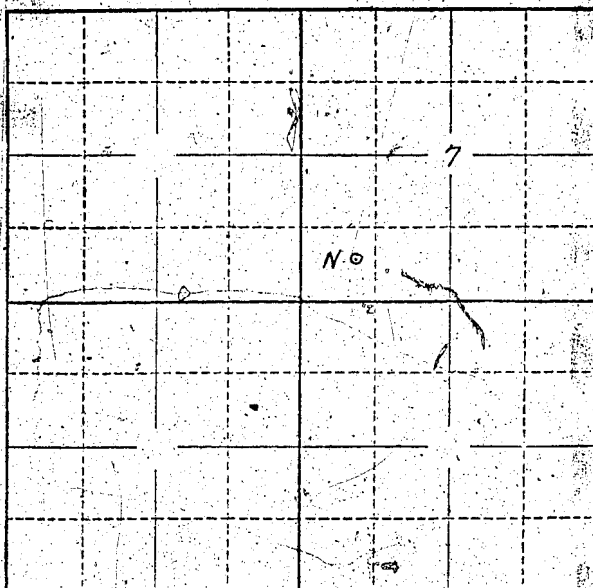

Locate well and acreage of irrigated land on plat.  
Scale: 2" = 1 Mile.

STATE OF OREGON

County of Benton } ss.

I, G. M. Eraser, being first duly sworn, do hereby certify that I have read the foregoing Registration Statement and that all of the items therein contained are true to the best of my knowledge and belief.

G. M. Eraser  
(Signature of Registrant)

Subscribed and sworn to before me this 30th day of July, 1958.

My commission expires Sept. 29, 1961  
Margaret B. Johnson  
(Notary Public)

(SEAL)

**CERTIFICATE OF REGISTRATION**

STATE OF OREGON

County of Marion } ss.

This is to certify that the foregoing Registration Statement was received in the office of the State Engineer on the 3 day of July, 1958, at 9:00 o'clock A. M. and has been duly recorded in said office in Book No. 13 of Registration Statements on page GR 3197.

Witness my hand this 20th day of July, 1959.

Laura A. [Signature]  
(State Engineer)

By \_\_\_\_\_  
(Deputy)

GR - 3197

#16<sup>50</sup>