

Registration Statement

OF CLAIMANT OF RIGHT TO APPROPRIATE GROUND WATER

Well # 2

TO THE STATE ENGINEER OF OREGON:

I, James Lake
of Rt. 2 Box 402 Eugene, Oregon County of Lane
(Mailing address)
State of Oregon, do hereby make application for a certificate of registration as evidence of a right to appropriate ground water.

- 1. Source from which water is withdrawn is Pump Well
(Flowing well, pump well, infiltration trench, or tunnel)
- 2. Location is: 3/4 Mile North Coburg, Oregon
(Approximate distance and direction from nearest city or town)

and is more particularly described as follows:

(a) N. 460' W. 230' From S. E. corner W. Ferguson D. L. J.
(Give distance and bearing to corner of section or other legal subdivision)
being within SW 1/4 of SW 1/4 of Sec. 29, Twp. 18S, Rge. 7W
(Smallest legal subdivision) (N. or S.) (E. or W.)

or (b) within limits of recorded platted property, town or city:

in Lot _____, Block _____ of _____
(Name of plat or addition)

County of _____
(If within city or town, give name)

3. Construction Work was begun on 3-25-1948 was completed on 1-1-48
(Date) (Date)

and the ground water claimed was first used for the purposes set out below on 1-1-48
(Date)
since which time the water has been used intermittently
(Continuously or intermittently)
from May to October
(Date) (Date)

4. Quantity of water claimed and used is 360 gallons per minute; 80 acre feet per year.

5. Purpose or Purposes for which water is used irrigation
(Domestic, irrigation, municipal, manufacturing, industrial, etc.)

6. Description of Well: Depth 20 feet. Type Driven (spider well)
(Dug or drilled)
diameter 3 2" Pipes inches. Elevation of ground at well site 290 feet, mean sea level.
(As near as known)
Depth to water table 14 feet.

7. Capacity of Well: _____ g.p.m. with _____ feet drawdown.
_____ g.p.m. with _____ feet drawdown.

Date of test _____


If Flowing Well: Measured discharge _____ g.p.m. on _____
(Date)

Shut-in pressure at ground surface _____ lbs. per sq. in. on _____
(Date)

Water is controlled by _____
(Cap, valve, etc.)

Township 16S Range 3W W.M.

North

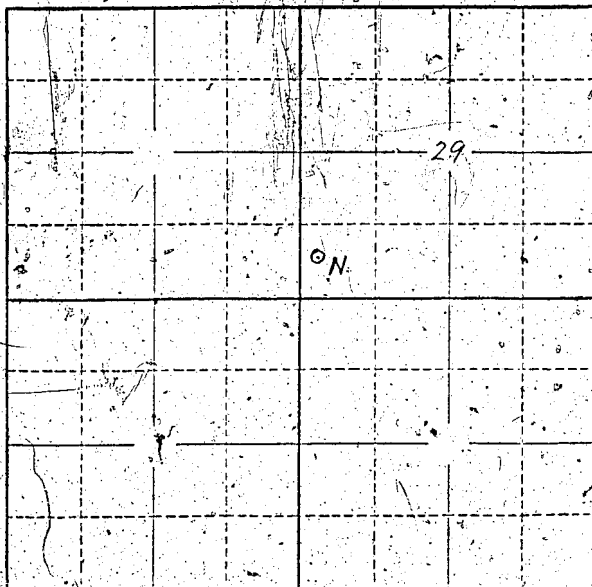

Locate well and acreage of irrigated land on plat.

Scale: 2" = 1 Mile

STATE OF OREGON

County of Clatsop

ss.

I, James Lake, being first duly sworn, do hereby certify that I have read the foregoing Registration Statement and that all of the items therein contained are true to the best of my knowledge and belief.

(Signature of Registrant)

Subscribed and sworn to before me this _____ day of _____, 19____.

My commission expires _____

(Notary Public)

(SEAL)

CERTIFICATE OF REGISTRATION

STATE OF OREGON

County of Marion

ss.

This is to certify that the foregoing Registration Statement was received in the office of the State Engineer on the 31 day of July, 1958, at 5:00 o'clock P.M. and has been duly recorded in said office in Book No. 13 of Registration Statements on page GR 3199

Witness my hand this 20th day of July, 1959

(State Engineer)

By _____

(Deputy)

GR 3199