

Registration Statement

OF CLAIMANT OF RIGHT TO APPROPRIATE GROUND WATER

(Under Chapter 708, Oregon Laws 1955.)

TO THE STATE ENGINEER OF OREGON:

Frank Popping

of Box 157 Mt Angel County of Marion

State of Oregon, do hereby make application for a certificate of registration as evidence of a right to appropriate ground water.

1. Source from which water is withdrawn is Pump well
(Flowing well, pump well, infiltration trench, or tunnel)

2. Location is: 1 mile South of Mt. Angel
(Approximate distance and direction from nearest city or town)

and is more particularly described as follows:

(a) 942.0' S. and 270.1' E. from N.W. Cor. Sec. 15
(Give distance and bearing to corner of section or other legal subdivision)

being within NW 1/4 of NW 1/4 of Sec. 15, Twp. 6 S, Rge. 1 W
(Smallest legal subdivision) (N. or S.) (E. or W.)

or (b) within limits of recorded platted property, town or city:

in Lot _____, Block _____ of _____
(Name of plat or addition)

County of _____
(If within city or town, give name)

3. Construction Work was begun on Sept. 15, 1951; was completed on Oct. 10, 1951
(Date) (Date)

and the ground water claimed was first used for the purposes set out below on April 1, 1952
(Date)

since which time the water has been used continuously during season
(Continuously or Intermittently)

from 1952 to Present 1956
(Date) (Date)

4. Quantity of water claimed and used is 300 gallons per minute; _____ acre feet per year.

5. Purpose or Purposes for which water is used Irrigation

(Domestic, irrigation, municipal, manufacturing, industrial, etc.)

6. Description of Well: Depth 141.81 feet. Type Drilled
(Dug or drilled)

diameter 3 inches. Elevation of ground at well site 175 feet, mean sea level.
(As near as known)

Depth to water table 15 feet.

7. Capacity of Well: 325 g.p.m. with 112 feet drawdown.

_____ g.p.m. with _____ feet drawdown.

Date of test Oct. 5, 1951

If Flowing Well: Measured discharge _____ g.p.m. on _____
(Date)

Shut-in pressure at ground surface _____ lbs. per sq. in. on _____
(Date)

Water is controlled by _____
(Cap, valve, etc.)

8. Casing: (Give diameter, commercial specifications and depth below ground surface of each casing size.)

8 inch diameter Standard black plain end pipe from 0 to 141.81 feet
 inch diameter from to feet
 inch diameter from to feet
 inch diameter from to feet

Describe and show depth of shoe, plug, adapter, liner or other details:

Steel drive shoe at botton of 8" casing

9. Perforated Casings or Screens:

4 slots 1x3" every 18" from 15' to 143'
 (Number per foot and size of perforations, or describe screen)

10. Log of Well: (Describe each stratum or formation clearly, indicate if water bearing, and give thickness and depth as indicated.)


MATERIAL	Thickness (Feet)	Depth to Bottom (Feet)
Blue clay	10'	10'
Cement gravel - accurate log wasn't kept on record	134.81'	144.81'

Commencing at the North ~~west~~ ^{east} corner of Section 16 T. 6 S. R. 1 W. of the Willamette Meridian; thence west on the sectionline 7.90 chains to near the middle of the county road leading to Mt Angel; thence South 19° 31' West along the middle of said road 20.84 chains to the middle intersection of said road with the road leading to Parkersville; thence South 63° 15' East along the middle of the last named road to point in the East boundary of the land described in the deed to Henry Stafford dated July 9, 1861 and recorded March 20 1865 in Vol. 7 page 447 of the Deed Records for Marion County, Oregon; Thence North along the East line of said Henry Stafford's land 34.63 chains to the North boundary of section 15, thence West 15.50 chains to the place of beginning and containing 74.5 acres more or less.

Save and except land conveyed to John H. Kuper and Louisa M. Kuper to Stephen Sprauer Walburger Sprauer, his wife, by deed dated April 3, 1911 and recorded April 21, 1911 in Vol. 13 page 205 Deeds Records for Marion County, Oregon

Township 6S Range 1W, W.M.

North

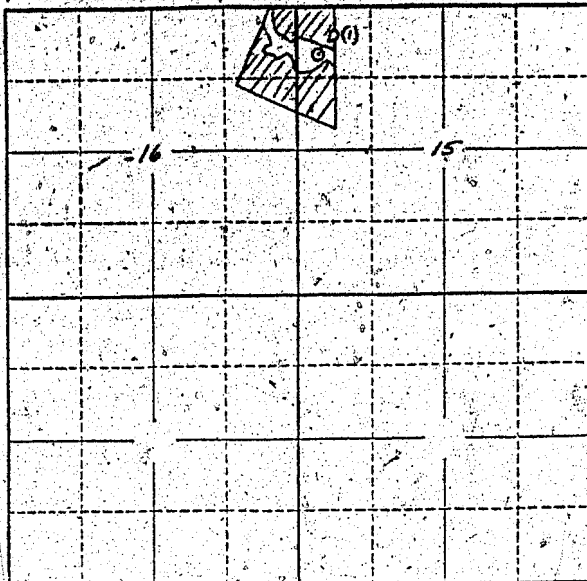

Locate well and acreage of irrigated land on plat.

Scale: 2" = 1 Mile.

STATE OF OREGON

County of Marion

ss.

I, Frank Poepping, being first duly sworn, do hereby certify that I have read the foregoing Registration Statement and that all of the items therein contained are true to the best of my knowledge and belief.

Frank Poepping
(Signature of Registrant)

Subscribed and sworn to before me this 23rd day of January, 1957

My commission expires Sept. 8, 1960

Chas. H. Stuber
(Notary Public)

(SEAL)

CERTIFICATE OF REGISTRATION

STATE OF OREGON

County of Marion

ss.

This is to certify that the foregoing Registration Statement was received in the office of the State Engineer on the 23rd day of January, 1957, at 10:00 o'clock A. M. and has been duly recorded in said office in Book No. 2 of Registration Statements on page GR-332 C

~~Construction shall be completed by 1958 and the water completely applied to beneficial use by 1958~~

Witness my hand this 15th day of April, 1957

Lewis A. Stanley
(State Engineer)

By

(Deputy)

GR-332C