

# Registration Statement

## OF CLAIMANT OF RIGHT TO APPROPRIATE GROUND WATER

TO THE STATE ENGINEER OF OREGON:

I, Richard E. McKay  
of Rt. 1 #389 Woodburn County of Marion  
(Mailing address)

State of Oregon, do hereby make application for a certificate of registration as evidence of a right to appropriate ground water.

- 1. Source from which water is withdrawn is Pumphill  
(Flowing well, pump well, infiltration trench, or tunnel)
- 2. Location is: about 3 miles S. E. of St. Paul  
(Approximate distance and direction from nearest city or town)

and is more particularly described as follows:

(a) 2110 feet west and 1250 feet south from NE corner Section 28  
(Give distance and bearing to corner of section or other legal subdivision)  
being within NW 1/4 of NE 1/4 of Sec. 28, Twp. 4S, Rge. 2W  
(Smallest legal subdivision) (or S.) (or W.)

or (b) within limits of recorded platted property, town or city:

in Lot \_\_\_\_\_, Block \_\_\_\_\_ of \_\_\_\_\_  
(Name of plat or addition)  
County of \_\_\_\_\_  
(If within city or town, give name)

3. Construction Work was begun on Sept. 15, 1942, was completed on Aug. 21, 1944  
(Date) (Date)  
and the ground water claimed was first used for the purposes set out below on Sept. 1, 1944  
(Date)  
since which time the water has been used Continuously  
(Continuously or intermittently)  
from Sept. 1, 1944 to July 30, 1958  
(Date) (Date)

4. Quantity of water claimed and used is 600 gallons per minute; \_\_\_\_\_ acre feet per year.

5. Purpose or Purposes for which water is used irrigation  
(Domestic, irrigation, municipal, manufacturing, industrial, etc.)

6. Description of Well: Depth 117 feet. Type drilled  
(Dug or drilled)  
diameter 10 inches. Elevation of ground at well site \_\_\_\_\_ feet, mean sea level.  
(As near as known)  
Depth to water table 14 feet.

7. Capacity of Well: 600 g.p.m. with 65 feet drawdown.  
300 g.p.m. with 45 feet drawdown.  
Date of test Sept 1, 1944

If Flowing Well: Measured discharge \_\_\_\_\_ g.p.m. on \_\_\_\_\_  
(Date)

Shut-in pressure at ground surface \_\_\_\_\_ lbs. per sq. in. on \_\_\_\_\_  
(Date)

Water is controlled by \_\_\_\_\_  
(Cap. valve, etc.)

8. Casing: (Give diameter, commercial specifications and depth below ground surface of each casing size.)

10 inch diameter *Steel casing* from 0 to 117 feet  
 inch diameter from to feet  
 inch diameter from to feet  
 inch diameter from to feet

Describe and show depth of shoe, plug, adapter, liner or other details:  
 .....  
 .....

9. Perforated Casings or Screens:

NO from to  
 (Number per foot and size of perforations, or describe screen)  
 from to  
 from to  
 from to

10. Log of Well: (Describe each stratum or formation clearly, indicate if water bearing, and give thickness and depth as indicated.)

MATERIAL	Thickness (Feet)	Depth to Bottom (Feet)
<i>NO record</i>		

If log of well is not available, give name and address of driller. Unknown

11. Infiltration Trench: Covered or open

Dimensions: Length ..... ft. Minimum depth ..... ft. Maximum depth ..... ft.  
 Bottom width ..... ft. Discharge ..... g.p.m. Date of test .....

12. Tunnel: Type of lining

Dimensions: .....  
(Length, course, and cross sectional size)  
 Position of water bearing stratum with reference to portal of tunnel .....

Log of tunnel: (Preceding table for log of well may be used, if desired. Give footage from portal and character of materials, as pertinent.)

13. Pumping Equipment:


(a) Pump Pumona Turbine Capacity ..... g.p.m.  
(Make, type and size)  
 (b) Motor 30 H.P. Electric Motor  
(Type and horsepower)

14. Location of area irrigated or to be irrigated, or place of use if for purposes other than irrigation.

Township North or South	Range E. or W. of Willamette Meridian	Section	Forty-acre Tract	Number Acres To Be Irrigated	Date of Reclamation
T4S	R2W	28	NE 1/4 of NE 1/4	25.0	1944
"	"	"	NW 1/4 of NE 1/4	25.0	"
"	"	"	SE 1/4 of NE 1/4	20.0	"
"	"	"	SW 1/4 of NE 1/4	20.0	"
"	"	"	NE 1/4 of NW 1/4	4.0	"
"	"	"	SE 1/4 of NW 1/4	6.0	"
				<u>100.0</u>	

15. If the ground water supply is supplemental to an existing water supply, identification of any application for a permit, permit, certificate or adjudicated right to appropriate water made or held by the registrant.

Township 45 Range 2W W.M.  
North

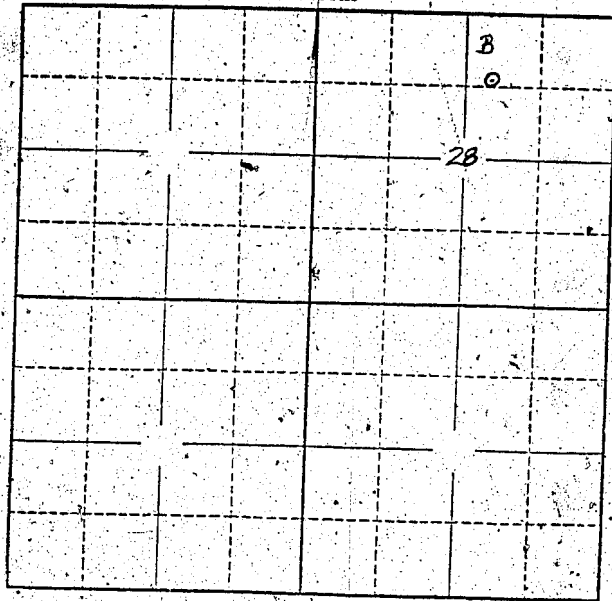

Locate well and acreage of irrigated land on plat.  
Scale: 2" = 1 Mile

STATE OF OREGON

County of Marion } ss.

I, Richard H. M. Kay, being first duly sworn, do hereby certify that I have read the foregoing Registration Statement and that all of the items therein contained are true to the best of my knowledge and belief.

Richard H. M. Kay  
(Signature of Registrant)

Subscribed and sworn to before me this 31st day of July, 1958

My commission expires 12th June 1961 Wm. S. Bartholomew  
(Notary Public)

(SEAL)

**CERTIFICATE OF REGISTRATION**

STATE OF OREGON

County of Marion } ss.

This is to certify that the foregoing Registration Statement was received in the office of the State Engineer on the 31st day of July, 1958, at 3:00 o'clock P.M. and has been duly recorded in said office in Book No. 13 of Registration Statements on page GR 3206

Witness my hand this 20th day of July, 1959

Laura A. Stanley  
(State Engineer)

By \_\_\_\_\_  
(Deputy)

\$25.50