

RECEIVED  
JUN 31 1958  
STATE ENGINEER OF OREGON

# Registration Statement

## OF CLAIMANT OF RIGHT TO APPROPRIATE GROUND WATER

TO THE STATE ENGINEER OF OREGON:

I, HOWARD E. SALVAGE  
of PO Box 293, Clifton County of CLATSOP  
State of ORE., do hereby make application for a certificate of registration as evidence of a right to appropriate ground water.

- 1. Source from which water is withdrawn is PUMP WELL #1  
(Flowing well, pump well, infiltration trench, or tunnel)
- 2. Location is: 1 Mile EAST OF CAVE JUNCTION ORE  
(Approximate distance and direction from nearest city or town)

and is more particularly described as follows:

- (a) 175' NORTH 184' EAST to the SW CORNER of the SE 1/4 of the SE 1/4 Sec. 22  
(Give distance and bearing to corner of section or other legal subdivision)  
being within SE 1/4 of SE 1/4 of Sec. 22, Twp. 39 S., Rge. 8 W.  
(Smallest legal subdivision) (N. or S.) (E. or W.)
- (b) within limits of recorded platted property, town or city:

in Lot \_\_\_\_\_, Block \_\_\_\_\_ of \_\_\_\_\_  
(If within city or town, give name) County of JOSEPHINE  
(Name of plat or addition)

3. Construction Work was begun on SEPT. 4, 1954; was completed on SEPT 7, 1954  
(Date) (Date)  
and the ground water claimed was first used for the purposes set out below on JUNE 5, 1955  
(Date)  
since which time the water has been used CONTINUOUSLY  
(Continuously or intermittently)  
from JUNE 5, 1955 to JULY 29, 1958  
(Date) (Date)

4. Quantity of water claimed and used is 15 gallons per minute; \_\_\_\_\_ acre feet per year.

5. Purpose or Purposes for which water is used Domestic (exempt) irrigation  
(Domestic, irrigation, municipal, manufacturing, industrial, etc.)

6. Description of Well: Depth 72 feet. Type Drilled  
(Dug or drilled)  
diameter 8" inches. Elevation of ground at well site 1150 feet, mean sea level.  
(As near as known)  
Depth to water table 30 feet.

7. Capacity of Well: 50 g.p.m. with 15 feet drawdown.  
\_\_\_\_\_ g.p.m. with \_\_\_\_\_ feet drawdown.

Date of test SEPT 7, 1954

If Flowing Well: Measured discharge \_\_\_\_\_ g.p.m. on \_\_\_\_\_  
(Date)


Shut-in pressure at ground surface \_\_\_\_\_ lbs. per sq. in. on \_\_\_\_\_  
(Date)

Water is controlled by \_\_\_\_\_  
(Cap, valve, etc.)





Township 39 S Range 8 W, W.M.  
North

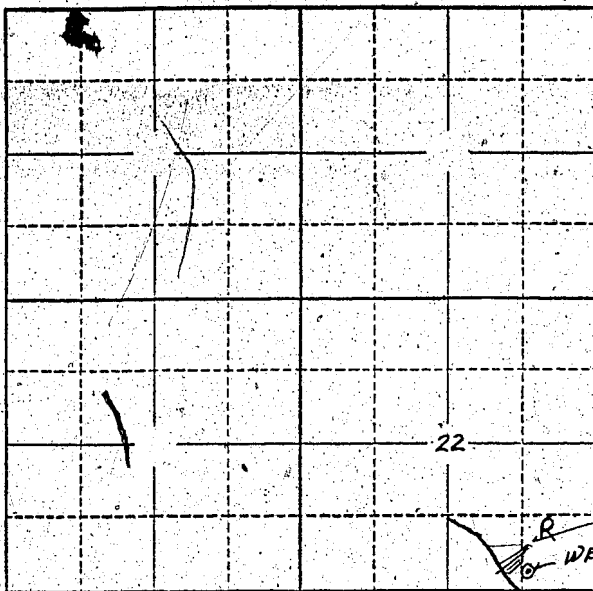

Locate well and acreage of irrigated land on plat.

Scale: 2" = 1 Mile

LAND TO BE IRRIGATED

OREGON CAVES Hwy W4

STATE OF OREGON

County of Klamath } ss.

I, Howard E. Savage, being first duly sworn, do hereby certify that I have read the foregoing Registration Statement and that all of the items therein contained are true to the best of my knowledge and belief.

Howard E. Savage  
(Signature of Registrant)

Subscribed and sworn to before me this 30th day of July, 1958.

My commission expires April 17-1962

Franklin M. Marking  
(Notary Public) for Oregon

(SEAL)

**CERTIFICATE OF REGISTRATION**

STATE OF OREGON

County of Marion } ss.

This is to certify that the foregoing Registration Statement was received in the office of the State Engineer on the 1st day of August, 1958, at 8<sup>00</sup> o'clock A. M. and has been duly recorded in said office in Book No. 16 of Registration Statements on page GR 3905

Witness my hand this 15th day of February, 1960

Louis A. Stanley  
(State Engineer)

By \_\_\_\_\_ (Deputy)

GR 3905

A 1500