

RECEIVED
JUL 31 1953
STATE ENGINEER

Registration No. GR-3469
Certificate No. GR-3906

Registration Statement

OF CLAIMANT OF RIGHT TO APPROPRIATE GROUND WATER

TO THE STATE ENGINEER OF OREGON:

I, HOWARD E. SALVAGE

of PO Box 293 Chilquin County of KLAMATH

State of OREGON, do hereby make application for a certificate of registration as evidence of a right to appropriate ground water.

1. Source from which water is withdrawn is PUMP WELL #2
(Flowing well, pump well, infiltration trench, or tunnel).

2. Location is: 1 Mile EAST of CAVE Junction ORE
(Approximate distance and direction from nearest city or town)

is more particularly described as follows:

(a) 369' North & 193' East of the S.W. Corner of the SE 1/4 of Sec 22
(Give distance and bearing to corner of section or other legal subdivision)

being within SE 1/4 of SE 1/4 of Sec. 22, Twp. 39 S, Rge. 8 W
(Smallest legal subdivision) (N. or S.) (E. or W.)

or (b) within limits of recorded platted property, town or city:

in Lot _____, Block _____ of _____
(Name of plat or addition)

County of Josephine
(If within city or town, give name)

3. Construction Work was begun on July 1947; was completed on July 1947
(Date) (Date)

and the ground water claimed was first used for the purposes set out below on July 1947
(Date)

since which time the water has been used Continuously
(Continuously or intermittently)

from July 1947 to July 29, 1958
(Date) (Date)

4. Quantity of water claimed and used is 15 gallons per minute; _____ acre feet per year.

5. Purpose or Purposes for which water is used ~~Domestic~~ + IRRIGATION
(Domestic, irrigation, municipal, manufacturing, industrial, etc.)

6. Description of Well: Depth 65 feet. Type Drilled
(Dug or drilled)

diameter 6" inches. Elevation of ground at well site 1350 feet, mean sea level.
(As near as known)

Depth to water table 27 feet.

7. Capacity of Well: 10 g.p.m. with 12 feet drawdown.

_____ g.p.m. with _____ feet drawdown.


Date of test July 1947

If Flowing Well: Measured discharge _____ g.p.m. on _____
(Date)

Shut-in pressure at ground surface _____ lbs. per sq. in. on _____
(Date)

Water is controlled by _____
(Cap, valve, etc.)

Township 39 S Range 84 W.M.
North

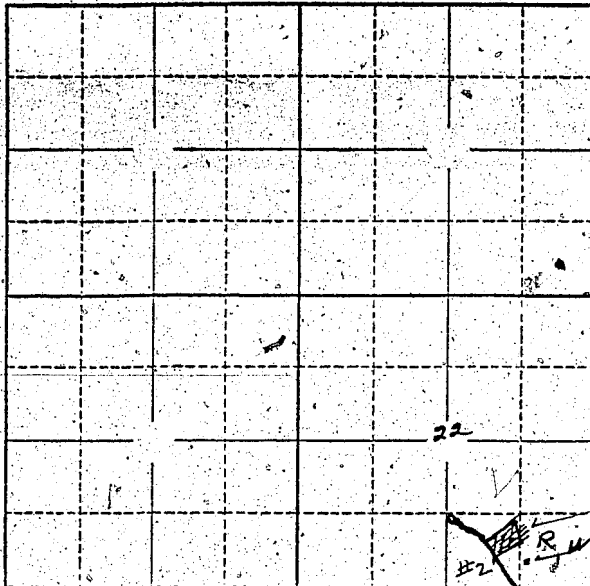

Locate well and acreage of irrigated land on plat.

Scale: 2" = 1 Mile

LAND TO BE IRRIGATED

OREGON CAVES HYDRO

STATE OF OREGON

County of Clatsop } ss.

I, Howard E. Shupe being first duly sworn, do hereby certify that I have read the foregoing Registration Statement and that all of the items therein contained are true to the best of my knowledge and belief.

Howard E. Shupe
(Signature of Registrant)

Subscribed and sworn to before me this 30th day of July, 1958.

My commission expires April 17-1962 Therette Markwardt
(Notary Public for Oregon)

(SEAL)

CERTIFICATE OF REGISTRATION

STATE OF OREGON

County of Marion } ss.

This is to certify that the foregoing Registration Statement was received in the office of the State Engineer on the 1st day of August, 1958, at 8:00 o'clock A. M. and has been duly recorded in said office in Book No. 16 of Registration Statements on page GR-3906

Witness my hand this 15th day of February, 1960.

Leura A. Stanley
(State Engineer)

By _____ (Deputy)

\$15.00