

# Registration Statement

## OF CLAIMANT OF RIGHT TO APPROPRIATE GROUND WATER

TO THE STATE ENGINEER OF OREGON:

I, P. A. Petzel  
of Rt 1 Box 318 Sumas County of Marion  
(Mailing address)

State of Oregon, do hereby make application for a certificate of registration as evidence of a right to appropriate ground water.

1. Source from which water is withdrawn is spring well  
(Flowing well, pump well, infiltration trench, or tunnel)

2. Location is: 3 miles west of Woodburn  
(Approximate distance and direction from nearest city or town)

and is more particularly described as follows: 470 feet north & 75 feet east from S 1/4 corner Section 11

(a) 450 ft. from corner (S.E.) (345' N. 230' W. of SE cor.  
(Give distance and bearing to corner of section or other legal subdivision)

being within S 1/4 of S E 1/4 of Sec. 11, Twp. 5S, Rge. 2' W Lot 14  
(Smallest legal subdivision) (or S.) (or W.)

or (b) within limits of recorded platted property, town or city:

in Lot 14, Block \_\_\_\_\_ of West Woodburn Fruit Farms  
(Name of plat or addition)

County of Marion  
(If within city or town, give name)

3. Construction Work was begun on 1954; was completed on 1954  
(Date) (Date)

and the ground water claimed was first used for the purposes set out below on 1954  
(Date)

since which time the water has been used continuously  
(Continuously or intermittently)

from May to Sept  
(Date) (Date)

4. Quantity of water claimed and used is 150 gallons per minute; 2.4 acre feet per year.

5. Purpose or Purposes for which water is used irrigation ~~\_\_\_\_\_~~

(Domestic, irrigation, municipal, manufacturing, industrial, etc.)

6. Description of Well: Depth 85 feet. Type Dug  
(Dug or drilled)

diameter 8 inches. Elevation of ground at well site \_\_\_\_\_ feet, mean sea level.  
(As near as known)

Depth to water table 20 feet.

7. Capacity of Well: 300 g.p.m. with \_\_\_\_\_ feet drawdown.

150 g.p.m. with 20 feet drawdown.

Date of test May 1954

If Flowing Well: Measured discharge \_\_\_\_\_ g.p.m. on \_\_\_\_\_  
(Date)

Shut-in pressure at ground surface \_\_\_\_\_ lbs. per sq. in. on \_\_\_\_\_  
(Date)

Water is controlled by \_\_\_\_\_  
(Cap, valve, etc.)



If log of well is not available, give name and address of driller. Mr. Miller (7)

11. Infiltration Trench: Covered or open .....

Dimensions: Length ..... ft. Minimum depth ..... ft. Maximum depth ..... ft.

Bottom width ..... ft. Discharge ..... g.p.m. Date of test .....

12. Tunnel: Type of lining .....

Dimensions: .....  
(Length, course, and cross sectional size)

Position of water bearing stratum with reference to portal of tunnel .....

Log of tunnel: (Preceding table for log of well may be used, if desired. Give footage from portal and character of materials, as pertinent.)

13. Pumping Equipment:

(a) Pump Barkley (Turbine) Capacity 160 g.p.m.  
(Make, type and size)


(b) Motor 10 h.p. elect  
(Type and horsepower)

14. Location of area irrigated or to be irrigated, or place of use if for purposes other than irrigation.

Township North or South	Range E. or W. of Willamette Meridian	Section	Portion of Tract	Number Acres To Be Irrigated	Date of Reclamation
5 S.	2 W.	11	<u>lots</u>		
			<u>14</u>	<u>7.0</u>	
			<u>15</u>	<u>5</u>	
			<u>16</u>	<u>5</u>	
			<u>17</u>	<u>5</u>	
			<u>18</u>	<u>5</u>	
			<u>or</u>	<u>27.0 Total</u>	
"	"	"	<u>SW 1/4 + SE 1/4</u>	<u>7.0</u>	<u>1954</u>
"	"	"	<u>SE 1/4 of SW 1/4</u>	<u>16.0</u>	"
"	"	"	<u>SW 1/4 of SW 1/4</u>	<u>4.0</u>	"
				<u>27.0 Total</u>	"

15. If the ground water supply is supplemental to an existing water supply, identification of any application for a permit, permit, certificate or adjudicated right to appropriate water made or held by the registrant.

Township 55 Range 2W W.M.  
North

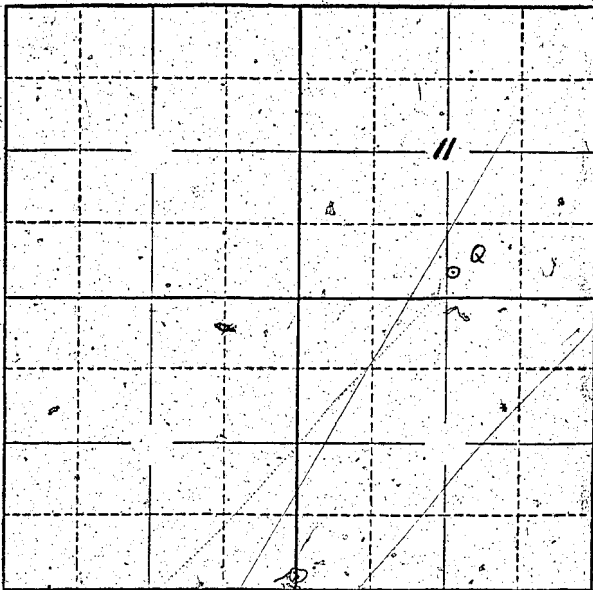

Locate well and acreage of irrigated land on plat.  
Scale: 2" = 1 Mile

STATE OF OREGON

County of Marion } ss.

I, Roy A Petzel, being first duly sworn, do hereby certify that I have read the foregoing Registration Statement and that all of the items therein contained are true to the best of my knowledge and belief.

Roy A. Petzel  
(Signature of Registrant)

Subscribed and sworn to before me this 31<sup>st</sup> day of July, 1958

My commission expires Sept. 8, 1960 Chas. L. ...  
(Notary Public)

(SEAL)

**CERTIFICATE OF REGISTRATION**

STATE OF OREGON

County of Marion } ss.

This is to certify that the foregoing Registration Statement was received in the office of the State Engineer on the 31<sup>st</sup> day of July, 1958, at 3<sup>00</sup> o'clock P. M. and has been duly recorded in said office in Book No. 13 of Registration Statements on page GR-3208

Witness my hand this 20<sup>th</sup> day of July, 1959

Lewis A. ...  
(State Engineer)

\$15.00

By \_\_\_\_\_  
(Deputy)