

RECEIVED

JAN 26 1957

STATE ENGINEER
SALEM, OREGON

Registration Statement

REGISTRATION NO. QR-348

CERTIFICATE NO. QR-334

OF CLAIMANT OF RIGHT TO APPROPRIATE GROUND WATER

(Under Chapter 708, Oregon Laws 1955.)

TO THE STATE ENGINEER OF OREGON:

I, Dee S. Chambers

of Route 2, Albany County of Linn

State of Oregon do hereby make application for a certificate of registration as evidence of a right to appropriate ground water.

1. Source from which water is withdrawn is pump well No. 2
(Flowing well, pump well, infiltration trench, or tunnel)

2. Location is: 10 miles north of Albany, Oregon
(Approximate distance and direction from nearest city or town)

and is more particularly described as follows:

(a) East 12.75 chains from the SW corner of S. 33, T. 9S, R. 3 W, W.M.
(Give distance and bearing to corner of section or other legal subdivision)

being within SW $\frac{1}{4}$ of SW $\frac{1}{4}$ of Sec. 33, Twp. 9 S., Rge. 3 W
(Smallest legal subdivision) (N. or S.) (E. or W.)

or (b) within limits of recorded platted property, town or city:

in Lot _____, Block _____ of _____
(Name of plat or addition)

County of Linn
(If within city or town, give name)

3. Construction Work was begun on May 7, 1947; was completed on May 12, 1947
(Date) (Date)

and the ground water claimed was first used for the purposes set out below on June 10, 1947
(Date)

since which time the water has been used continuously
(Continuously or intermittently)

from June 10, 1947 to present time
(Date) (Date)

4. Quantity of water claimed and used is 320 gallons per minute; 30.75 acre feet per year.

5. Purpose or Purposes for which water is used irrigation

(Domestic, irrigation, municipal, manufacturing, industrial, etc.)

6. Description of Well: Depth 20 feet. Type driven
(Dug or drilled)

diameter 4 inches. Elevation of ground at well site 190 feet, mean sea level.
(As near as known)

Depth to water table 12 feet.

7. Capacity of Well: 350 g.p.m. with 4 feet drawdown.

_____ g.p.m. with _____ feet drawdown.

Date of test not tested

If Flowing Well: Measured discharge _____ g.p.m. on _____
(Date)

Shut-in pressure at ground surface _____ lbs. per sq. in. on _____
(Date)

Water is controlled by _____
(Cap, valve, etc.)

If log of well is not available, give name and address of driller, Driven by former owner

11. Infiltration Trench: Covered or open

Dimensions: Length ft. Minimum depth ft. Maximum depth ft.
 Bottom width ft. Discharge g.p.m. Date of test

12. Tunnel: Type of lining

Dimensions:
(Length, course, and cross sectional size)
 Position of water bearing stratum with reference to portal of tunnel

Log of tunnel: (Preceding table for log of well may be used, if desired. Give footage from portal and character of materials, as pertinent.)

13. Pumping Equipment:

(a) Pump Allis Chalmers 2 1/2" Centrifugal Capacity 350 g.p.m.
(Make, type and size)

(b) Motor 15 H.P. electric
(Type and horsepower)

14. Location of area irrigated or to be irrigated, or place of use if for purposes other than irrigation.


Township North or South	Range E. or W. of Willamette Meridian	Section	Forty-acre Tract	Number Acres To Be Irrigated	Date of Reclamation
10 S.	3 W.	4	NW 1/4 of NW 1/4	5.0	June 10, 1947
9 S.	3 W.	33	SW 1/4 of SW 1/4	7.3	June 10, 1947
				12.3	

228-486

Beginning 6.90 chains east of the southwest corner of Section 33, T. 9 S., R. 3 W. of the Will. Mer.; thence North to the North line of Lot 4 in said section; thence southeasterly up the Santiam River to a point which is 12.82 chains east of the west line of said section; thence south to the center of the County Road; thence west along the center of said County Road 1.82 chains; thence north 17.82 chains to the center of a slough, thence Northwesterly down the center of said slough to a point 6.90 chains east and 29 chains South of the Northwest corner of Section 4, T. 10 S., R. 3 W. of the Will. Mer.; thence North 29 chains to the point of beginning in Linn County, Oregon.

15. If the ground water supply is supplemental to an existing water supply, identification of any application for a permit, permit, certificate or adjudicated right to appropriate water made or held by the registrant.

Township 9 & 10 S Range 3 W, W.M.
North

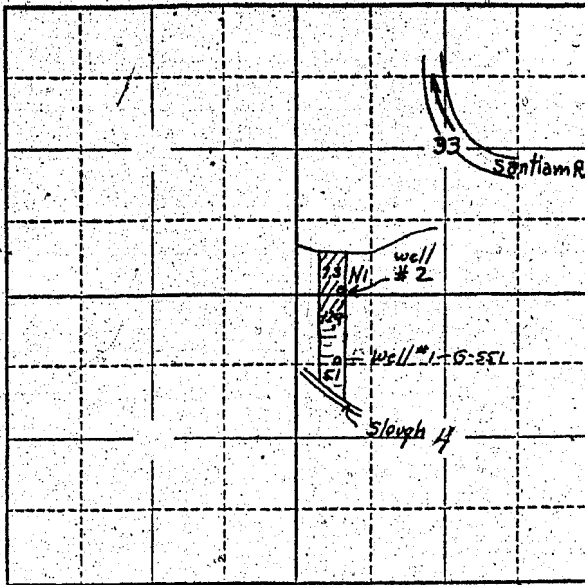

See G-551
for Map

Locate well and acreage of irrigated land on plat.
Scale: 2" = 1 Mile

STATE OF OREGON

County of Linn } ss.

I, Dee S. Chambers, being first duly sworn, do hereby certify that I have read the foregoing Registration Statement and that all of the items therein contained are true to the best of my knowledge and belief.

Dee S. Chambers
(Signature of Registrant)

Subscribed and sworn to before me this 15th day of January, 1957

My commission expires Oct 2 - 1957

[Signature]
(Notary Public)

(SEAL)

CERTIFICATE OF REGISTRATION

STATE OF OREGON }
County of Marion } ss.

This is to certify that the foregoing Registration Statement was received in the office of the State Engineer on the 25 day of January, 1957, at 8:00 o'clock A.M. and has been duly recorded in said office in Book No. 2 of Registration Statements on page GR-334 C.

~~XY Construction shall be completed by X-X-X-X-X-X-X-X-X-X-X-X-X-X-X-X and the water completely applied to beneficial use by X-X-X-X-X-X-X-X-X-X-X-X-X-X-X-X~~

Witness my hand this 1st day of April, 1957

Lewis A. Stanley
(State Engineer)

\$15.00

By _____
(Deputy)

GR-334C