

Registration Statement

OF CLAIMANT OF RIGHT TO APPROPRIATE GROUND WATER

TO THE STATE ENGINEER OF OREGON:

I, Simpson Redwood Company dba Simpson Logging Company

of 2301 N. Columbia Blvd., Portland County of Multnomah
(Mailing address)

State of Oregon do hereby make application for a certificate of registration as evidence of a right to appropriate ground water.

1. Source from which water is withdrawn is Pump Well
(Flowing well, pump well, infiltration trench, or tunnel)

2. Location is: 380' north of Portland city limits
(Approximate distance and direction from nearest city or town)

and is more particularly described as follows:

(a) 1390' north and 230' east of southwest corner
(Give distance and bearing to corner of section or other legal subdivision)

being within NE 1/4 section of Sec. 9, Twp. 1N, Rge. 1E
(Smallest legal subdivision) (N. or S.) (E. or W.)

or (b) within limits of recorded platted property, town or city:

in Lot _____, Block _____ of _____
(Name of plat or addition)

County of _____
(If within city or town, give name)

3. Construction Work was begun on 1932, Spring; was completed on _____
(Date) (Date)

and the ground water claimed was first used for the purposes set out below on 1932, Summer
(Date)

since which time the water has been used continuously
(Continuously or intermittently)

from _____ to _____
(Date) (Date)

4. Quantity of water claimed and used is 122 gallons per minute; _____ acre feet per year.

5. Purpose or Purposes for which water is used industrial
(Domestic, irrigation, municipal, manufacturing, industrial, etc.)

6. Description of Well: Depth 60 feet. Type drilled
(Dug or drilled)

diameter 8 inches. Elevation of ground at well site 39.5 feet, mean sea level.
(As near as known)

Depth to water table 24 feet.

7. Capacity of Well: _____ g.p.m. with _____ feet drawdown.

_____ g.p.m. with _____ feet drawdown.


Date of test _____

If Flowing Well: Measured discharge _____ g.p.m. on _____
(Date)

Shut-in pressure at ground surface _____ lbs. per sq. in. on _____
(Date)

Water is controlled by _____
(Cap, valve, etc.)

Township 1N Range 1E W.M.
North

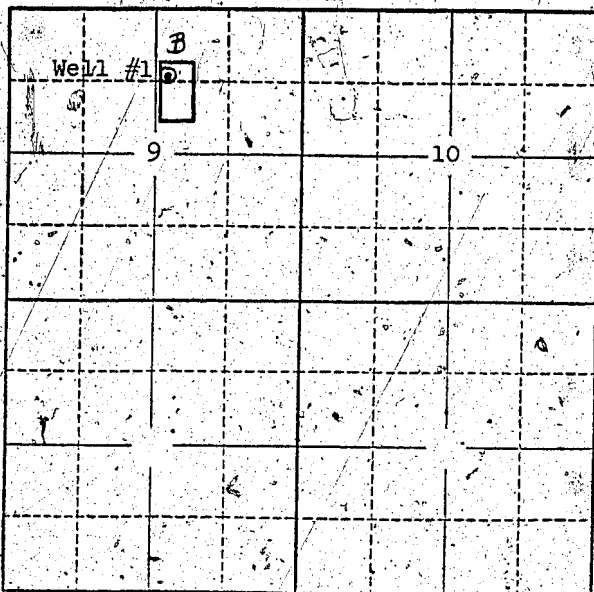

Locate well and acreage of irrigated land on plat.
Scale: 2" = 1 Mile

STATE OF OREGON

County of MULTNOMAH

ss.

I, Harold A. Ahlskog, being first duly sworn, do hereby certify that I have read the foregoing Registration Statement and that all of the items therein contained are true to the best of my knowledge and belief.

SIMPSON REDWOOD COMPANY dba SIMPSON LOGGING COMPANY

[Signature]
(Signature of Registrant) Mgr. Mgr.

Subscribed and sworn to before me this 29th day of July, 1958.

My commission expires Sept. 27, 1959

[Signature]
(Notary Public)

(SEAL)

CERTIFICATE OF REGISTRATION

STATE OF OREGON

County of Marion

ss.

This is to certify that the foregoing Registration Statement was received in the office of the State Engineer on the 31st day of July, 1958, at 2 o'clock A.M. and has been duly recorded in said office in Book No. 13 of Registration Statements on page GR-3214.

Witness my hand this 20th day of July, 1959.

[Signature]
(State Engineer)

By _____ (Deputy)

GR-3214

\$20.00