

# Registration Statement

## OF CLAIMANT OF RIGHT TO APPROPRIATE GROUND WATER

RECEIVED  
MAY 21 1959  
STATE ENGINEER  
SALMON, OREGON

TO THE STATE ENGINEER OF OREGON:

I, Malby A. Schneider dba Schneider Lumber Company

of P.O. Box 186, Brownsville, Oregon County of Linn

State of Oregon, do hereby make application for a certificate of registration as evidence of a right to appropriate ground water:

1. Source from which water is withdrawn is Pump #1  
(Flowing well, pump well, infiltration trench, or tunnel)

2. Location is: 1 mile west of Brownsville, Oregon  
(Approximate distance and direction from nearest city or town)

and is more particularly described as follows:

(a) 211 ft S 90° 20' W to SW corner of Sec 1  
(Give distance and bearing to corner of section or other legal subdivision)

being within SW 1/4 of Sec. 1, Twp. 11S, Rge. 2E  
(Smallest legal subdivision) (N. or S.) (E. or W.)

or (b) within limits of recorded platted property, town or city:

in Lot \_\_\_\_\_, Block \_\_\_\_\_ of \_\_\_\_\_  
(Name of plat or addition)

County of \_\_\_\_\_  
(If within city or town, give name)

3. Construction Work was begun on June 15, 1945; was completed on June 30, 1945  
(Date) (Date)

and the ground water claimed was first used for the purposes set out below on June 30, 1945  
(Date)

since which time the water has been used Continuously  
(Continuously or intermittently)

from June 30, 1945 to July 30, 1958 (Date)

4. Quantity of water claimed and used is 35 gallons per minute; \_\_\_\_\_ acre feet per year.

5. Purpose or Purposes for which water is used for irrigation  
use, also for drinking purposes.  
(Domestic, irrigation, municipal, manufacturing, industrial, etc.)

6. Description of Well: Depth 40 feet. Type Drilled  
(Dug or drilled)  
diameter 5 inches. Elevation of ground at well site 730 feet, mean sea level.  
(As near as known)  
Depth to water table 20 feet.

7. Capacity of Well: \_\_\_\_\_ g.p.m. with \_\_\_\_\_ feet drawdown.  
\_\_\_\_\_ g.p.m. with \_\_\_\_\_ feet drawdown.

Date of test Not Tested

If Flowing Well: Measured discharge None flowing well g.p.m. on \_\_\_\_\_  
(Date)


Shut-in pressure at ground surface \_\_\_\_\_ lbs. per sq. in. on \_\_\_\_\_  
(Date)

Water is controlled by \_\_\_\_\_  
(Cap, valve, etc.)





Township 14.5 Range 3 W, W.M.  
North

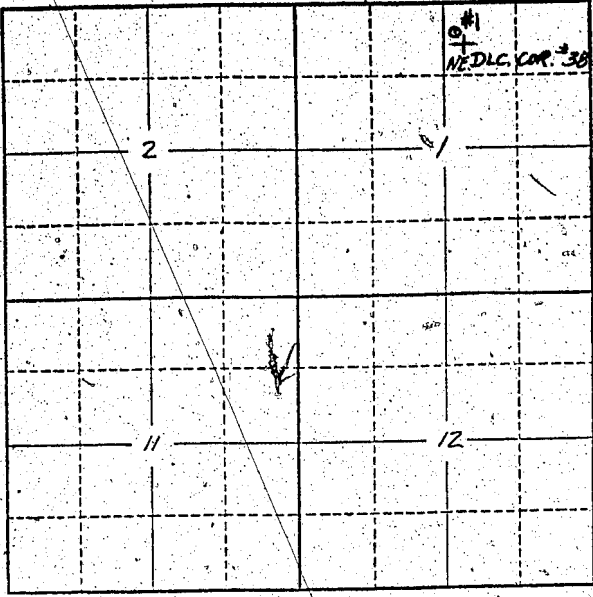

Locate well and acreage of irrigated land on plat.  
Scale: 2" = 1 Mile

STATE OF OREGON

County of \_\_\_\_\_ } ss.

I, \_\_\_\_\_, being first duly sworn, do hereby certify that I have read the foregoing Registration Statement and that all of the items therein contained are true to the best of my knowledge and belief.

\_\_\_\_\_  
(Signature of Registrant)

Subscribed and sworn to before me this \_\_\_\_\_ day of \_\_\_\_\_, 19\_\_\_\_

My commission expires \_\_\_\_\_  
(Notary Public)

(SEAL)

**CERTIFICATE OF REGISTRATION**

STATE OF OREGON

County of Marion } ss.

This is to certify that the foregoing Registration Statement was received in the office of the State Engineer on the 31st day of July, 1959, at 1:00 o'clock P. M. and has been duly recorded in said office in Book No. 17 of Registration Statements on page GR-4091

Witness my hand this 13th day of June, 1960

\_\_\_\_\_  
(State Engineer)

#2000

By \_\_\_\_\_  
(Deputy)

GR 4091