

# Registration Statement

## OF CLAIMANT OF RIGHT TO APPROPRIATE GROUND WATER

### TO THE STATE ENGINEER OF OREGON:

I, Welby A. Schneider dba Schneider Lumber Company

of P. O. Box 188, Brownsville, Oregon County of Linn

State of Oregon, do hereby make application for a certificate of registration as evidence of a right to appropriate ground water.

1. Source from which water is withdrawn is Pump Well #3  
(Flowing well, pump well, infiltration trench, or tunnel)

2. Location is: 1 Mile West of Brownsville, Oregon  
(Approximate distance and direction from nearest city or town)

and is more particularly described as follows:

(a) 1100 feet S 101 1/2 to NE corner  
(Give distance and bearing to corner of section or other legal subdivision)

being within NE 1/4 NW 1/4 of Sec. 1, Twp. 14S, Rge. 23E  
(Smallest legal subdivision) (N. or S.) (E. or W.)

or (b) within limits of recorded platted property, town or city:

in Lot \_\_\_\_\_, Block \_\_\_\_\_ of \_\_\_\_\_  
(Name of plat or addition)

County of \_\_\_\_\_  
(If within city or town, give name)

3. Construction Work was begun on June 1, 1945; was completed on June 15, 1945  
(Date) (Date)

and the ground water claimed was first used for the purposes set out below on June 15, 1945  
(Date)

since which time the water has been used continuously  
(Continuously or intermittently)

from June 15, 1945 to date (July 30, 1958)  
(Date) (Date)

4. Quantity of water claimed and used is 3 gallons per minute; 45 acre feet per year.

5. Purpose or Purposes for which water is used Industrial mill uses, not for drinking purposes.  
(Domestic, irrigation, municipal, manufacturing, industrial, etc.)

6. Description of Well: Depth 40 feet. Type drilled  
(Dug or drilled)

diameter 8 inches. Elevation of ground at well site \_\_\_\_\_ feet, mean sea level.  
(As near as known)

Depth to water table 20 feet.

7. Capacity of Well: \_\_\_\_\_ g.p.m. with \_\_\_\_\_ feet drawdown.

\_\_\_\_\_ g.p.m. with \_\_\_\_\_ feet drawdown.

Date of test \_\_\_\_\_

If Flowing Well: Measured discharge Does not apply g.p.m. on \_\_\_\_\_  
(Date)

Shut-in pressure at ground surface \_\_\_\_\_ lbs. per sq. in. on \_\_\_\_\_  
(Date)

Water is controlled by \_\_\_\_\_  
(Cap, valve, etc.)

8. Casing: (Give diameter, commercial specifications and depth below ground surface of each casing size.)

8 inch diameter ..... from top to 40 feet

..... inch diameter ..... from ..... to ..... feet

..... inch diameter ..... from ..... to ..... feet

..... inch diameter ..... from ..... to ..... feet

Describe and show depth of shoe, plug, adapter, liner or other details:

.....

.....

.....

9. Perforated Casings or Screens:

(Number per foot and size of perforations, or describe screen)

..... from ..... to .....

..... from ..... to .....

..... from ..... to .....

..... from ..... to .....

10. Log of Well: (Describe each stratum or formation clearly, indicate if water bearing, and give thickness and depth as indicated.)

MATERIAL	Thickness (Feet)	Depth to Bottom (Feet)
<del>.....</del>	<del>.....</del>	<del>.....</del>
.....	.....	.....
.....	.....	.....
If log of well is not available, give name and address of driller. ~~None available~~

11. Infiltration Trench: Covered or open ..... None

Dimensions: Length ..... ft. Minimum depth ..... ft. Maximum depth ..... ft.

Bottom width ..... ft. Discharge ..... g.p.m. Date of test .....

12. Tunnel: Type of lining ..... No Tunnel

Dimensions: .....  
(Length, course, and cross sectional size)

Position of water bearing stratum with reference to portal of tunnel .....

Log of tunnel: (Preceding table for log of well may be used, if desired. Give footage from portal and character of materials, as pertinent.)

13. Pumping Equipment:

Pacific Model N4BF S/N 10K11241G

(a) Pump Jacuzzi Model 5KC55EELNX Capacity <sup>25</sup> ~~25000~~ g.p.m.

(Make, type and size)

1/2 HP General Electric

(b) Motor 1/2 HP General Electric


(Type and horsepower)

14. Location of area irrigated or to be irrigated, or place of use if for purposes other than irrigation.

Township North or South	Range E. or W. of Willamette Meridian	Section	Forty-acre Tract	Number Acres To Be Irrigated	Date of Reclamation
T14S	R3W	1	NE 1/4 of NW 1/4	Industrial	1945

15. If the ground water supply is supplemental to an existing water supply, identification of any application for a permit, permit, certificate or adjudicated right to appropriate water made or held by the registrant.

Township 45 Range 3W W.M.  
North

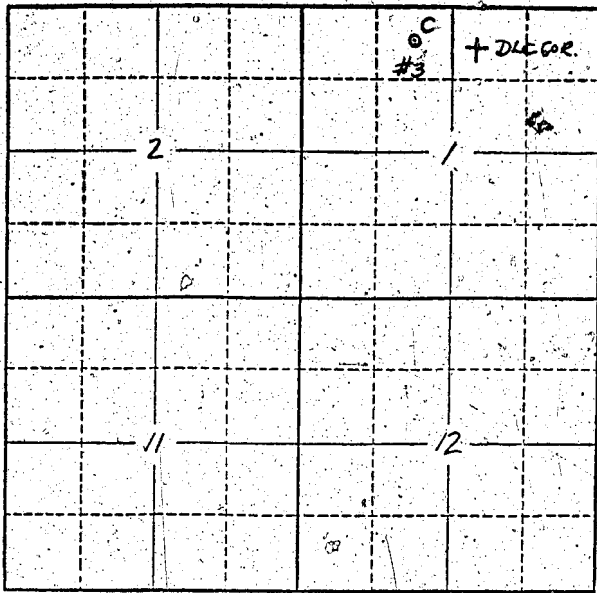

Locate well and acreage of irrigated land on plat.  
Scale: 2" = 1 Mile

STATE OF OREGON

County of Marion } ss.

I, [Signature], being first duly sworn, do hereby certify that I have read the foregoing Registration Statement and that all of the items therein contained are true to the best of my knowledge and belief.

.....  
(Signature of Registrant)

Subscribed and sworn to before me this ..... day of ....., 19 .....

My commission expires .....  
(Notary Public)

(SEAL)

**CERTIFICATE OF REGISTRATION**

STATE OF OREGON } ss.  
County of Marion

This is to certify that the foregoing Registration Statement was received in the office of the State Engineer on the 31st day of July, 1960, at 1:00 o'clock P. M. and has been duly recorded in said office in Book No. 17 of Registration Statements on page GR-4093.

Witness my hand this 13th day of June, 19 60  
[Signature]  
(State Engineer)

By .....  
(Deputy)

GR 4093

\$20.00