

OF CLAIMANT OF RIGHT TO APPROPRIATE GROUND WATER

(Under Chapter 708, Oregon Laws 1955.)

TO THE STATE ENGINEER OF OREGON:

I, Vicente Williamson
of 336, OAK ST. Salem County of Marion

State of _____, do hereby make application for a certificate of registration as evidence of a right to appropriate ground water.

1. Source from which water is withdrawn is PUMP WELL
(Flowing well, pump well, infiltration trench, or tunnel).

2. Location is: 9 mi. N.E. of Salem, Hazel Green Dist.
(Approximate distance and direction from nearest city or town)

and is more particularly described as follows:

(a) Approximately 850 feet east & 1690 feet north from S.W. corner of Sec. 17
(Give distance and bearing to corner of section or other legal subdivision)
being within N.W. 1/4 to S.W. 1/4 of Sec. 17, Twp. 6 S. Rge. 2 W.
(Smallest legal subdivision) (N. or S.) (E. or W.)

or (b) within limits of recorded platted property, town or city: _____

in Lot A, Block _____ of _____
(Name of plat or addition)

County of _____
(If within city or town, give name)

3. Construction Work was begun on July 1950; was completed on July 1950
(Date) (Date)

and the ground water claimed was first used for the purposes set out below on July 23, 1950
(Date)

since which time the water has been used Continuously
(Continuously or Intermittently)

from July 1950 to Present time 1956
(Date) (Date)

4. Quantity of water claimed and used is 480 gallons per minute; _____
feet per year.

5. Purpose or Purposes for which water is used Irrigation
(Domestic, irrigation, municipal, manufacturing, industrial, etc.)

6. Description of Well: Depth 110 feet. Type Drilled
(Dug or drilled)

diameter 10 inches. Elevation of ground at well site 175 feet, mean sea level.
(As near as known)

Depth to water table 5 feet.

7. Capacity of Well: _____ g.p.m. with _____ feet drawdown.
_____ g.p.m. with _____ feet drawdown.

Date of test _____

If Flowing Well: Measured discharge _____ g.p.m. on _____
(Date)


Shut-in pressure at ground surface _____ lbs. per sq. in. on _____
(Date)

Water is controlled by _____
(Cap, valve, etc.)



Township 6S Range 2W W.M.

North

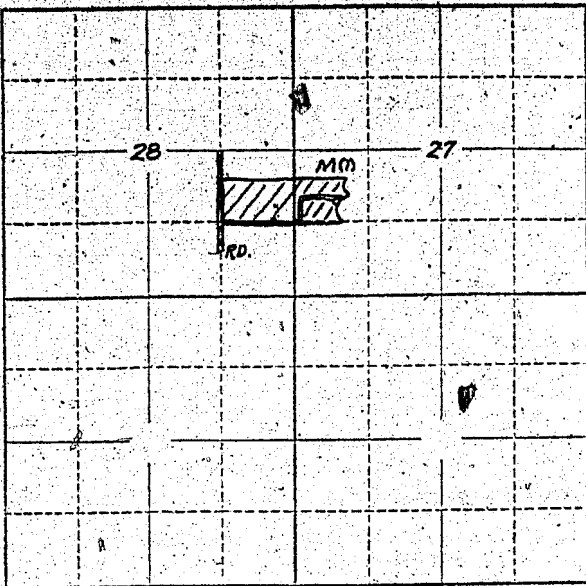

Locate well and acreage of irrigated land on plat.

Scale: 2" = 1 Mile

STATE OF OREGON

County of Marion } ss.

I, Victor Williamson being first duly sworn, do hereby certify that I have read the foregoing Registration Statement and that all of the items therein contained are true to the best of my knowledge and belief.

Victor Williamson
(Signature of Registrant)

Subscribed and sworn to before me this 28 day of Jan., 1957

My commission expires Dec 18, 1960

[Signature]
(Notary Public)

(SEAL)

CERTIFICATE OF REGISTRATION

STATE OF OREGON } ss.
County of Marion

This is to certify that the foregoing Registration Statement was received in the office of the State Engineer on the 28th day of January, 1957 at 10:00 o'clock A. M. and has been duly recorded in said office in Book No. 2 of Registration Statements on page GR-335 C.

~~Construction shall be completed by X-X-X-X-X-X-X-X-19-X-X and the water completely applied to beneficial use by X-X-X-X-X-X-X-X-19-X-X-X-X~~

Witness my hand this 1st day of April, 1957.

Lewis A. Stanley
(State Engineer)

\$17.85

By _____ (Deputy)

GR-335C