

Registration Statement

STATEMENT OF CLAIMANT OF RIGHT TO APPROPRIATE GROUND WATER

TO THE STATE ENGINEER OF OREGON:

I, Artie W. and Opal P. Morris
of Rt 3 Box 265 Milton Freewater County of Umatilla
(Mailing address)

State of Oregon, do hereby make application for a certificate of registration as evidence of a right to appropriate ground water.

1. Source from which water is withdrawn is Pump well
(Flowing well, pump well, infiltration trench, or tunnel)

2. Location is: 2 Miles north of Milton Freewater
(Approximate distance and direction from nearest city or town)

and is more particularly described as follows:

(a) ~~840~~ 840 feet north and 90 ft east of S.W. corner of Sec. 25
(Give distance and bearing to corner of section or other legal subdivision)

being within S.W. of S.W. of Sec. 25, Twp. 6 N. Rge. 35 E.
(Smallest legal subdivision) (N. or S.) (E. or W.)

or (b) within limits of recorded platted property, town or city:

in Lot _____ Block _____ of _____
(Name of plat or addition)

County of _____
(If within city or town, give name)

3. Construction Work was begun on 1910; was completed on 1910
(Date) (Date)

and the ground water claimed was first used for the purposes set out below on 1910
(Date)

since which time the water has been used Continuously
(Continuously or intermittently)

from May 1st to October 1st
(Date) (Date)

4. Quantity of water claimed and used is 175 gallons per minute; 10 acre feet per year.

5. Purpose or Purposes for which water is used Irrigation

(Domestic, irrigation, municipal, manufacturing, industrial, etc.)

6. Description of Well: Depth 72 feet. Type Dug 50' drilled 22'
(Type of well)

diameter 6 feet. Elevation of ground at well site 930 feet, mean sea level.
(AS near as known)

Depth to water table 15 high 3.5 low feet.

7. Capacity of Well: 300 g.p.m. with _____ feet drawdown.
_____ g.p.m. with _____ feet drawdown.

Date of test _____

If Flowing Well: Measured discharge _____ g.p.m. on _____
(Date)

Shut-in pressure at ground surface _____ lbs. per sq. in. on _____
(Date)

Water is controlled by _____
(Cap, valve, etc.)

8. Casing: (Give diameter, commercial specifications and depth below ground surface of each casing size.)

6 feet inch diameter from *0* to *50* feet
8 inch diameter from *50* to *72* feet
 inch diameter from to feet
 inch diameter from to feet

Describe and show depth of shoe, plug, adapter, liner or other details:

9. Perforated Casings or Screens:

..... from to
(Number per foot and size of perforations, or describe screen)
 from to
 from to
 from to

10. Log of Well: (Describe each stratum or formation clearly, indicate if water bearing, and give thickness and depth as indicated.)

None

MATERIAL	Thickness (Feet)	Depth to Bottom (Feet)

If log of well is not available, give name and address of driller.

11. Infiltration Trench: Covered or open

Dimensions: Length ft. Minimum depth ft. Maximum depth ft.

Bottom width ft. Discharge g.p.m. Date of test

12. Tunnel: Type of lining

Dimensions:
(Length, course, and cross sectional size)

Position of water bearing stratum with reference to portal of tunnel

Log of tunnel: (Preceding table for log of well may be used, if desired. Give footage from portal and character of materials, as pertinent.)

13. Pumping Equipment:

(a) Pump 2 1/2 centrifugal pump Capacity 175 g.p.m.
(Make, type and size)

(b) Motor 3 H.P. electric
(Type and horsepower)

14. Location of area irrigated or to be irrigated, or place of use if for purposes other than irrigation.

Township North or South	Range E. or W. of Willamette Meridian	Section	Forty-acre Tract	Number Acres To Be Irrigated	Date of Reclamation
6 N.	35 E.	25	N.W. of S.W. of S.W.	7.0	1911


15. If the ground water supply is supplemental to an existing water supply, identification of any application for a permit, permit, certificate or adjudicated right to appropriate water made or held by the registrant.

No other supply.

Section 25

Township 6 N Range 35 E, W.M.

North

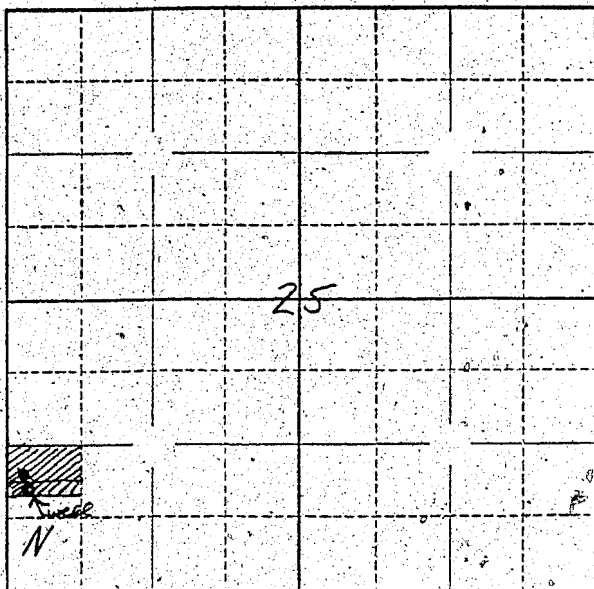

Locate well and acreage of irrigated land on plat.

Scale: 7 - 1 Mile

STATE OF OREGON



(Signature of Registrant)

Subscribed and sworn to before me this 2nd day of February, 1960

My commission expires 3-27-63

J. R. ...
(Notary Public)

(SEAL)

CERTIFICATE OF REGISTRATION

STATE OF OREGON

County of Marion } ss.

This is to certify that the foregoing Registration Statement was received in the office of the State Engineer on the 31st day of July, 1958, at 1:00 o'clock P. M. and has been duly recorded in said office in Book No. 16 of Registration Statements on page GR-3007

Witness my hand this 15th day of February, 1960

Lawrence A. Stanley
(State Engineer)

By _____ (Deputy)

GR 3007

\$15.00