

Registration Statement

OF CLAIMANT OF RIGHT TO APPROPRIATE GROUND WATER

Well #1 1926

TO THE STATE ENGINEER OF OREGON:

I, James Seed Company

of 1235 Goodpasture Road, Eugene County of Lane
(Mailing address)

State of OREGON, do hereby make application for a certificate of registration as evidence of a right to appropriate ground water.

1. Source from which water is withdrawn is pump well
(Flowing well, pump well, infiltration trench, or tunnel)

2. Location is: 4 miles North of Eugene, Oregon
(Approximate distance and direction from nearest city or town)

and is more particularly described as follows:

(a) N 18° 30' W 528 feet from SW corner a Goodpasture DLC #78
(Give distance and bearing to corner of section or other legal subdivision)
being within NW 1/4 of SE 1/4 of Sec. 13, Twp. 17 S, Rge. 4W
(Smallest legal subdivision) (N. or S.) (E. or W.)

or (b) within limits of recorded platted property, town or city:

in Lot _____, Block _____ of _____
(Name of plat or addition)

County of _____
(If within city or town, give name)

3. Construction Work was begun on 1926; was completed on 1926
(Date) (Date)

and the ground water claimed was first used for the purposes set out below on 1926
(Date)

since which time the water has been used each year during irrigation season
(Continuously or intermittently)

from 1926 to present
(Date) (Date)

4. Quantity of water claimed and used is: 200 gallons per minute; 28 acre feet per year.

5. Purpose or Purposes for which water is used irrigation

(Domestic, irrigation, municipal, manufacturing, industrial, etc.)

6. Description of Well: Depth 25 feet. Type dug 18" piped down to 25'
(Dug or drilled)

diameter 4 inches. Elevation of ground at well site 420 feet, mean sea level.
(As near as known)

Depth to water table 16 feet.

7. Capacity of Well: 200 g.p.m. with _____ feet drawdown.
_____ g.p.m. with _____ feet drawdown.

Date of test yearly

If Flowing Well: Measured discharge _____ g.p.m. on _____
(Date)

Shut-in pressure at ground surface _____ lbs. per sq. in. on _____
(Date)

Water is controlled by _____
(Cap, valve, etc.)

8. Casing: (Give diameter, commercial specifications and depth below ground surface of each casing size.)

36" inch diameter from 0 to -19 feet
4" inch diameter from -19' to -25' feet
inch diameter from to feet
inch diameter from to feet

Describe and show depth of shoe, plug, adapter, liner or other details: lower 4' is perforated with 1/2" x 4" slots

9. Perforated Casings or Screens:

Lower 4' is perforated with 1/4" x 4" slots 2" apart from 21' to 25' (Number per foot and size of perforations, or describe screen)
from to
from to
from to

10. Log of Well: (Describe each stratum or formation clearly, indicate if water bearing, and give thickness and depth as indicated.)

MATERIAL	Thickness (Feet)	Depth to Bottom (Feet)
River Loam	4'	-4'
water bearing sand and gravel	-4'	-25'

If log of well is not available, give name and address of driller.

11. **Infiltration Trench:** Covered or open

Dimensions: Length ft. Minimum depth ft. Maximum depth ft.

Bottom width ft. Discharge g.p.m. Date of test

12. **Tunnel:** Type of lining

Dimensions:
(Length, course, and cross-sectional size)

Position of water bearing stratum with reference to portal of tunnel

Log of tunnel: (Preceding table for log of well may be used, if desired. Give footage from portal and character of materials, as pertinent.)

13. **Pumping Equipment:**

(a) Pump Fairbanks Morse centrifugal Capacity 200 g.p.m.
(Make, type and size)


(b) Motor 3 phase electric 10 H.P.
(Type and horsepower)

14. **Location of area irrigated or to be irrigated, or place of use if for purposes other than irrigation.**

Township North or South	Range E. or W. of Willamette Meridian	Section	Forty-acre Tract	Number Acres To Be Irrigated	Date of Reclamation
17 S	4 W	13	SW 1/4 of NE 1/4	3.1	1926
17 S	4W	13	NW 1/4 of SE 1/4	24.6	"
17 S	4W	13	NE 1/4 of SW 1/4	0.2	"
				<u>27.9</u>	

15. If the ground water supply is supplemental to an existing water supply, identification of any application for a permit, permit, certificate or adjudicated right to appropriate water made or held by the registrant.

Township 17 S Range 4 W W.M.
North

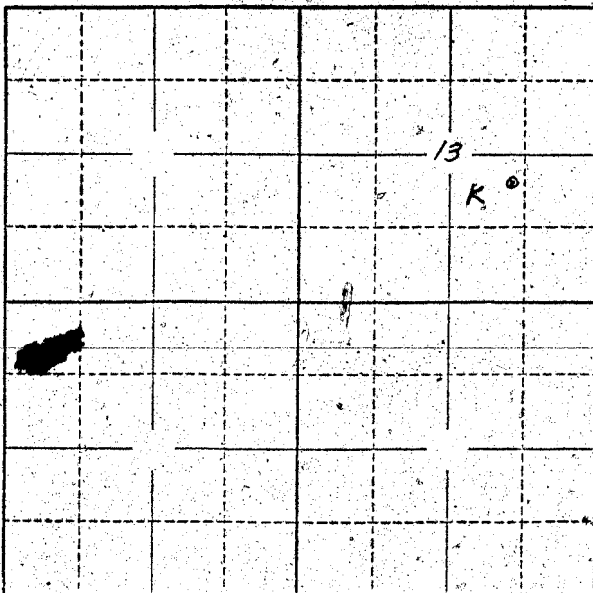

Locate well and acreage of irrigated land on plat.

Scale: 2" = 1 Mile

STATE OF OREGON

County of Lane } ss.

I, William Jesse James, being first duly sworn, do hereby certify that I have read the foregoing Registration Statement and that all of the items therein contained are true to the best of my knowledge and belief.

William Jesse James
(Signature of Registrant)

Subscribed and sworn to before me this 25th day of July, 1959.

My commission expires June 23, 1961.

Deputy J. L. [unclear]
(Notary Public)

(SEAL)

CERTIFICATE OF REGISTRATION

STATE OF OREGON

County of Marion } ss.

This is to certify that the foregoing Registration Statement was received in the office of the State Engineer on the 31st day of July, 1959, at 1:00 o'clock P. M. and has been duly recorded in said office in Book No. 15 of Registration Statements on page GR-3628

Witness my hand this 15th day of September, 1959

Lewis A. Stanley
(State Engineer)

By _____ (Deputy)

4
15^{cc}