

65196 15 M

REGISTRATION NO. GR-35

CERTIFICATE NO. GR-30

Registration Statement

OF CLAIMANT OF RIGHT TO APPROPRIATE GROUND WATER

(Under Chapter 708, Oregon Laws 1955.)

TO THE STATE ENGINEER OF OREGON:

I, Grover C. Gillespie
of 5750 Quinsaby Rd County of Marrion

State of Oregon, do hereby make application for a certificate of registration as evidence of a right to appropriate ground water.

1. Source from which water is withdrawn is pump well
(Flowing well, pump well, infiltration trench, or tunnel)

2. Location is: Six miles North of Salem
(Approximate distance and direction from nearest city or town)

and is more particularly described as follows:

(a) 400 feet East of Quinsaby Rd + 150 North of South Boundary
(Give distance and bearing to corner of section or other legal subdivision)

being within SW 1/4 & NE 1/4 of Sec. 36, Twp. 6 S, Rge. 3 W
(Smallest legal subdivision) (N. or S.) (E. or W.)

or (b) within limits of recorded platted property, town or city:

in Lot _____, Block _____ of _____
(Name of plat or addition)

County of _____
(If within city or town, give name)

3. Construction Work was begun on May 1957; was completed on May 1959
(Date) (Date)

and the ground water claimed was first used for the purposes set out below on June 1953
(Date)

since which time the water has been used intermittently
(Continuously or intermittently)

from June 1953 to Sep 1955
(Date) (Date)

4. Quantity of water claimed and used is 250 gallons per minute; 8.4 acre feet per year.

5. Purpose or Purposes for which water is used Irrigating Berries
(Domestic, irrigation, municipal, manufacturing, industrial, etc.)

6. Description of Well: Depth about 60 feet. Type Drilled
(Dug or drilled)

diameter 8 inches. Elevation of ground at well site 180 feet, mean sea level.
(As near as known)

Depth to water table 20 feet.

7. Capacity of Well: 252 g.p.m. with None feet drawdown.

_____ g.p.m. with _____ feet drawdown.


Date of test July 1954

If Flowing Well: Measured discharge _____ g.p.m. on _____
(Date)

Shut-in pressure at ground surface _____ lbs. per sq. in. on _____
(Date)

Water is controlled by _____
(Cap, valve, etc.)

Township 6 S Range 2 W W.M.
North

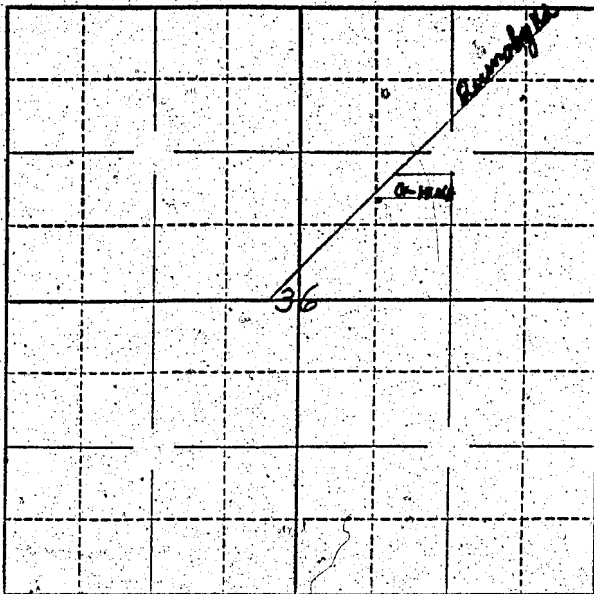

Locate well and acreage of irrigated land on plat.

Scale: $\frac{2''}{4''} = 1 \text{ Mile}$

STATE OF OREGON

County of Marion } ss.

I, Grover C. Gillespie, being first duly sworn, do hereby certify that I have read the foregoing Registration Statement and that all of the items therein contained are true to the best of my knowledge and belief.

Grover C. Gillespie
(Signature of Registrant)

Subscribed and sworn to before me this 9th day of December, 1955.

My commission expires Dec 27, 1955

Robert R. Suther
(Notary Public)

(SEAL)

CERTIFICATE OF REGISTRATION

STATE OF OREGON

County of Marion } ss.

This is to certify that the foregoing Registration Statement was received in the office of the State Engineer on the 8th day of November, 1955, at 2:05 o'clock P.M. and has been duly recorded in said office in Book No. 1 of Registration Statements on page 30.

Construction shall be completed by _____, 19____ and the water completely applied to beneficial use by _____, 19____.

Witness my hand this 24th day of February, 1956.

Lewis A. Stanley
(State Engineer)

By _____
(Deputy)