

Registration Statement

OF CLAIMANT OF RIGHT TO APPROPRIATE GROUND WATER

RECEIVED
MAR 22 1946
STATE ENGINEER

TO THE STATE ENGINEER OF OREGON:

Northwestern Christian Home

of 3400 S W 103rd Ave County of Multnomah
(Mailing address)

State of Oregon, do hereby make application for a certificate of registration as evidence of a right to appropriate ground water.

1. Source from which water is withdrawn is pump well
(Flowing well, pump well, infiltration trench; or tunnel)

2. Location is: NE 1/4 S E corner Walker Rd and S W 103rd Ave Beaverton Ore
(Approximate distance and direction from nearest city or town)

and is more particularly described as follows:

(a) Approx 1882 Ft S 29°-24' W To SW Cor. Sec. 11
(Give distance and bearing to corner of section or other legal subdivision)

being within NW 1/4 of SW 1/4 of Sec. 11 Twp. 15 Rge. 1 W
(Smallest legal subdivision) (N. or S.) (E. or W.)

or (b) within limits of recorded platted property, town or city:

in Lot _____, Block _____ of _____
(Name of plat or addition)

County of Washington
(If within city or town, give name)

3. Construction Work was begun on July, 1946; was completed on Sept 26 1946
(Date) (Date)

and the ground water claimed was first used for the purposes set out below on Sept 28 1946
(Date)

since which time the water has been used continuously
(Continuously or intermittently)

from Sept 26 1946 to _____ date
(Date) (Date)

4. Quantity of water claimed and used is 19 gallons per minute; _____ acre feet per year.

5. Purpose or Purposes for which water is used non drinking and irrigation

(Domestic, irrigation, municipal, manufacturing, industrial, etc.)

6. Description of Well: Depth 276 feet. Type drilled
(Dug or drilled)

diameter 6 or 8" inches. Elevation of ground at well site approx 190 feet, mean sea level.
(As near as known)

Depth to water table 50 feet.

7. Capacity of Well: 19 g.p.m. with no feet drawdown.

20 g.p.m. with _____ feet drawdown. started to draw down.

Date of test Sept 26 1946


If Flowing Well: Measured discharge _____ g.p.m. on _____
(Date)

Shut-in pressure at ground surface _____ lbs. per sq. in. on _____
(Date)

Water is controlled by _____
(Cap, valve, etc.)

Township A 15 Range 1 W W.M.

North

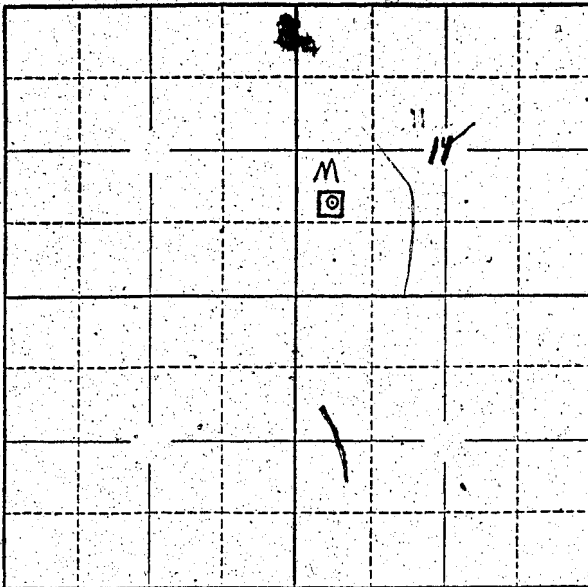

Locate well and acreage of irrigated land on plat.

Scale: 2" = 1 Mile

STATE OF OREGON

County of Multnomah } ss.

I, Leighton W. Johnson being first duly sworn, do hereby certify that I have read the foregoing Registration Statement and that all of the items therein contained are true to the best of my knowledge and belief.

Leighton W. Johnson
(Signature of Registrant)

Subscribed and sworn to before me this 28 day of July, 1958
My Commission Expires Jan. 13, 1962

My commission expires _____
Charles H. Hawkins
(Notary Public)

(SEAL)

CERTIFICATE OF REGISTRATION

STATE OF OREGON } ss.
County of Marion

This is to certify that the foregoing Registration Statement was received in the office of the State Engineer on the 4th day of August 4th, 1958, at 9:00 o'clock A. M. and has been duly recorded in said office in Book No. 16 of Registration Statements on page GR 4040

Witness my hand this 16th day of May, 19 60

Lewis A. Ottavio
(State Engineer)

By _____
(Deputy)

\$15.00

GR 4040