

Registration Statement

OF CLAIMANT OF RIGHT TO APPROPRIATE GROUND WATER

TO THE STATE ENGINEER OF OREGON:

I, CITY WATER DEPARTMENT

of BOX 190, SALEM, OREGON County of MARION

State of OREGON do hereby make application for a certificate of registration as evidence of a right to appropriate ground water.

1. Source from which water is withdrawn is INFILTRATION GALLERY #1
(Flowing well, pump well, infiltration trench, or tunnel)

2. Location is: One mile east of Stayton, Oregon
(Approximate distance and direction from nearest city or town)

and is more particularly described as follows: See Reference Point on attached map

(a) 1060' S and 1375' E of NW Corner of Sec 13
(Give distance and bearing to corner of section or other legal subdivision)

being within NE 1/4 of NW 1/4 of Sec. 13 Twp. 9S Rge. 1W
(Smallest legal subdivision) (N. or S.) (E. or W.)

or (b) within limits of recorded platted property, town or city:

in Lot _____ Block _____ of _____
(Name of plat or addition)

County of Linn
(If within city or town, give name)

3. Construction Work was begun on 1936; was completed on 1937
(Date) (Date)

and the ground water claimed was first used for the purposes set out below on Oct. 20, 1937
(Date)

since which time the water has been used Continuously
(Continuously or intermittently)

from 1937 to Present
(Date) (Date)

4. Quantity of water claimed and used is 5555 gallons per minute; _____ acre feet per year.

5. Purpose or Purposes for which water is used Municipal Water Supply

(Domestic, irrigation, municipal, manufacturing, industrial, etc.)

6. Description of Well: Depth _____ feet. Type _____
(Dug or drilled)

diameter _____ inches. Elevation of ground at well site _____ feet, mean sea level.
(As near as known)

Depth to water table _____ feet.

7. Capacity of Well: _____ g.p.m. with _____ feet drawdown.

_____ g.p.m. with _____ feet drawdown.

Date of test _____

If Flowing Well: Measured discharge _____ g.p.m. on _____
(Date)

Shut-in pressure at ground surface _____ lbs. per sq. in. on _____
(Date)

Water is controlled by _____
(Cap, valve, etc.)

8. Casing: (Give diameter, commercial specifications and depth below ground surface of each casing size.)

..... inch diameter from to feet

..... inch diameter from to feet

..... inch diameter from to feet

..... inch diameter from to feet

Describe and show depth of shoe, plug, adapter, liner or other details:

.....

.....

9. Perforated Casings or Screens:

(Number per foot and size of perforations, or describe screen) from to

..... from to

..... from to

..... from to

10. Log of Well: (Describe each stratum or formation clearly, indicate if water bearing, and give thickness and depth as indicated.)

| MATERIAL | Thickness (Feet) | Depth to Bottom (Feet) |
|----------|------------------|------------------------|
| | | |
| | | |
If log of well is not available, give name and address of driller.

11. Infiltration ~~Trench~~ ^{GALLERY} Covered or open Covered
 Dimensions: Length ft. Minimum depth 5 ft. Maximum depth ft.
 Bottom width ft. Discharge 5555 g.p.m. Date of test Flow records 1947-1948

* See description below
 12. Tunnel: Type of lining

Dimensions:
 (Length, course, and cross sectional size)
 Position of water bearing stratum with reference to portal of tunnel

Log of tunnel: (Preceding table for log of well may be used, if desired. Give footage from portal and character of materials, as pertinent.)

13. Pumping Equipment:
 (a) Pump NONE Capacity g.p.m.
 (Make, type and size)
 (b) Motor
 (Type and horsepower)


14. Location of area irrigated or to be irrigated, or place of use if for purposes other than irrigation.

| Township North or South | Range E. or W. of Willamette Meridian | Section | Forty-acre Tract | Number Acres To Be Irrigated | Date of Reclamation |
|-----------------------------------------|---------------------------------------|---------|------------------|------------------------------|---------------------|
| City of Salem and adjacent service area | | | | | |
| T75 | R3W | 22 | E 1/2 | Municipal | 1937 |
| T95 | R3W | 23 | W 1/2 | " | " |
| " | " | 27 | all | " | " |
| " | " | 28 | all | " | " |
| " | " | 34 | N 1/2 | " | " |
| " | " | 35 | N 1/2 | " | " |
| " | " | 24 | all | " | " |

* Infiltration gallery consists of 3700 feet of 30" perforated steel pipe and 160 feet of 18" perforated steel pipe laid at an average depth of 7 feet under sand and gravel filter media.

15. If the ground water supply is supplemental to an existing water supply, identification of any application for a permit, permit, certificate or adjudicated right to appropriate water made or held by the registrant.
 Cert. No. 12033, Application No. 25569, State Engineer Special Order Records Vol. 7, P. 233,
 Permit No. 373L, and eight registration statements accompanying this one.

Township 9S Range 1W W.M.
North

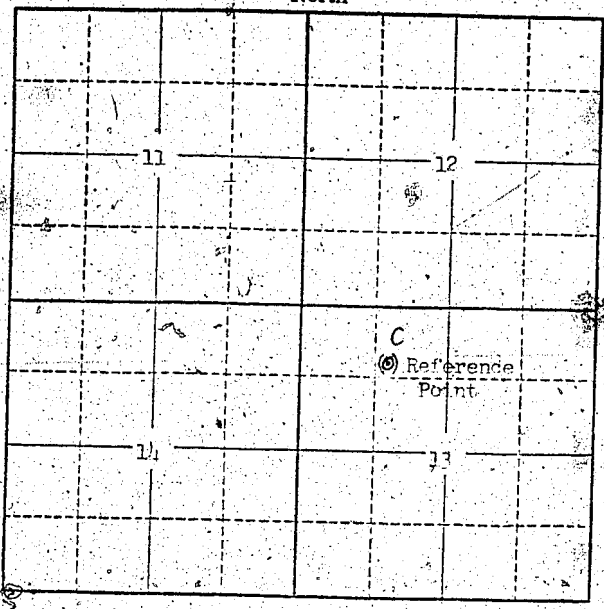

Locate well and acreage of irrigated land on plat.
Scale: 2" = 1 Mile

STATE OF OREGON

County of MARION } ss.

I, JOHN L. GREEN, being first duly sworn, do hereby certify that I have read the foregoing Registration Statement and that all of the items therein contained are true to the best of my knowledge and belief.

John L. Green, Mgr
(Signature of Registrant)

Subscribed and sworn to before me this 10 day of July, 1958.

My commission expires Jan 31 1961
(Notary Public)

(SEAL)

CERTIFICATE OF REGISTRATION

STATE OF OREGON

County of Marion } ss.

This is to certify that the foregoing Registration Statement was received in the office of the State Engineer on the 31st day of July, 1958, at 2:00 o'clock P. M. and has been duly recorded in said office in Book No. 13 of Registration Statements on page GR-3223

Witness my hand this 20th day of July, 1959

Laura A. Stenberg
(State Engineer)

By _____ (Deputy)

GR 3223

\$ 44.00