

# Registration Statement

## OF CLAIMANT OF RIGHT TO APPROPRIATE GROUND WATER

TO THE STATE ENGINEER OF OREGON:

I, CITY WATER DEPARTMENT

of SALEM County of CLATSOP  
(Mailing address)

State of OREGON do hereby make application for a certificate of registration as evidence of a right to appropriate ground water.

1. Source from which water is withdrawn is PUMP WELL  
(Flowing well, pump well, infiltration trench, or tunnel)

2. Location is: STANTON ISLAND, APPROX. 2 MI. E. OF STANTON  
(Approximate distance and direction from nearest city or town)

and is more particularly described as follows: WELL # 12

(a) S30° S & 540' E OF NW Cor Sec 13  
(Give distance and bearing to corner of section or other legal subdivision)

being within NW 1/4 NW 2 of Sec. 13, Twp. 9S, Rge. 1W  
(Smallest legal subdivision) (or S.) (or W.)

or (b) within limits of recorded platted property, town or city:

in Lot \_\_\_\_\_, Block \_\_\_\_\_ of \_\_\_\_\_  
(Name of plat or addition)

County of LINN  
(If within city or town, give name)

3. Construction Work was begun on UNKNOWN; was completed on 1910  
(Date) (Date)

and the ground water claimed was first used for the purposes set out below on 1910  
(Date)

since which time the water has been used CONTINUOUSLY  
(Continuously or intermittently)

from 1910 to PRESENT  
(Date) (Date)

4. Quantity of water claimed and used is 1550 gallons per minute; \_\_\_\_\_ acre feet per year.

5. Purpose or Purposes for which water is used MUNICIPAL WATER SUPPLY  
(Domestic, irrigation, municipal, manufacturing, industrial, etc.)

6. Description of Well: Depth 50 feet. Type DRILLED  
(Dug or drilled)

diameter 2 1/2 I.D. inches. Elevation of ground at well site 465 feet, mean sea level.  
(As near as known)

Depth to water table 12 feet.

7. Capacity of Well: 1550 g.p.m. with 100 feet drawdown.

\_\_\_\_\_ g.p.m. with \_\_\_\_\_ feet drawdown.

Date of test 12-24-10

If Flowing Well: Measured discharge \_\_\_\_\_ g.p.m. on \_\_\_\_\_  
(Date)

Shut-in pressure at ground surface \_\_\_\_\_ lbs. per sq. in. on \_\_\_\_\_  
(Date)

Water is controlled by \_\_\_\_\_  
(Cap, valve, etc.)

8. Casing: (Give diameter, commercial specifications and depth below ground surface of each casing size.)

..... inch diameter NO CASING DATA AVAILABLE ..... from ..... to ..... feet  
..... inch diameter ..... from ..... to ..... feet  
..... inch diameter ..... from ..... to ..... feet  
..... inch diameter ..... from ..... to ..... feet

Describe and show depth of shoe, plug, adapter, liner or other details: .....

1 STATE PREP. LOG OF 2" SECTION

9. Perforated Casings or Screens:

9" STRAINER WELDED TO SHERTON ..... from ..... to .....  
(Number per foot and size of perforations, or describe screen)  
(NO FURTHER DATA AVAILABLE) ..... from ..... to .....  
..... from ..... to .....  
..... from ..... to .....

10. Log of Wells: (Describe each stratum or formation clearly, indicate if water bearing, and give thickness and depth as indicated.)

MATERIAL	Thickness (Feet)	Depth to Bottom (Feet)
<u>LOG OF WELL NOT AVAILABLE</u>		

If log of well is not available, give name and address of driller. NOT KNOWN

11. Infiltration Trench: Covered or open \_\_\_\_\_  
 Dimensions: Length \_\_\_\_\_ ft. Minimum depth \_\_\_\_\_ ft. Maximum depth \_\_\_\_\_ ft.  
 Bottom width \_\_\_\_\_ ft. Discharge \_\_\_\_\_ g.p.m. Date of test \_\_\_\_\_

12. Tunnel: Type of lining \_\_\_\_\_  
 Dimensions: \_\_\_\_\_  
(Length, course, and cross sectional size)  
 Position of water bearing stratum with reference to portal of tunnel \_\_\_\_\_

Log of tunnel: (Preceding table for log of well may be used, if desired. Give footage from portal and character of materials, as pertinent.)


13. Pumping Equipment:  
 (a) Pump STERLING VERTICAL TURBINE, 10" Capacity 1550 g.p.m.  
(Make, type and size)  
 (b) Motor U.S. MOTOR, S.W., 10 H.P.  
(Type and horsepower)

14. Location of area irrigated or to be irrigated, or place of use if for purposes other than irrigation.

Township North or South	Range E. or W. of Willamette Meridian	Section	Forty-acre Tract	Number Acres To Be Irrigated	Date of Reclamation
WELL USED FOR STAND-BY FOR CITY OF SALEM WATER SUPPLY					
City of Salem and adjacent service area					
T75	R3W	22	E 1/2	Municipal	1930
"	"	23	W 1/2	"	"
"	"	24	all	"	"
"	"	28	all	"	"
"	"	27	all	"	"
"	"	34	W 1/2	"	"
"	"	35	N 1/2	"	"

15. If the ground water supply is supplemental to an existing water supply, identification of any application for a permit, permit, certificate or adjudicated right to appropriate water made or held by the registrant.  
 Cert. No. 12033, Application No. 25562, State Engineer Special Order Records Vol 7, P. 222  
 Permit No. 2731, and eight registration statements accompanying this one.

Township 25 Range 17 W.M.  
North

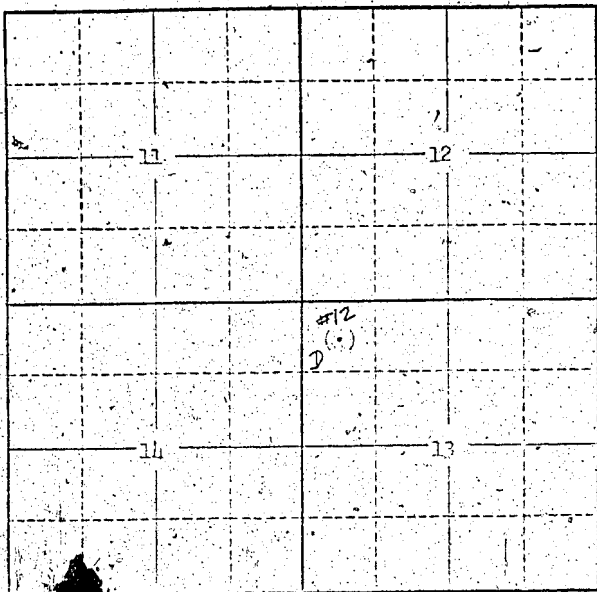

Locate well and acreage of irrigated land on plat.  
Scale: 2" = 1 Mile

STATE OF OREGON

County of MARION } ss.

I, JOHN L. DEAN, being first duly sworn, do hereby certify that I have read the foregoing Registration Statement and that all of the items therein contained are true to the best of my knowledge and belief.

*John L. Dean*  
(Signature of Registrar)

Subscribed and sworn to before me this 30 day of July, 1959

My commission expires July 1, 1961 (Notary Public)

(SEAL)

CERTIFICATE OF REGISTRATION

STATE OF OREGON

County of Marion } ss.

This is to certify that the foregoing Registration Statement was received in the office of the State Engineer on the 31st day of July, 1959 at 4 o'clock P.M. and has been duly recorded in said office in Book No. 13 of Registration Statements on page GR 3227

Witness my hand this 20th day of July, 1959

(State Engineer)

By (Deputy)

\$26.00

GR - 3227